




EAST LONGMEADOW DEPARTMENT OF PUBLIC WORKS

Job: 252 Elm St (water)
Sheet No: House to be Demolished of _____
Calculated By: Pope Date: 10-15-2020
Scale: _____

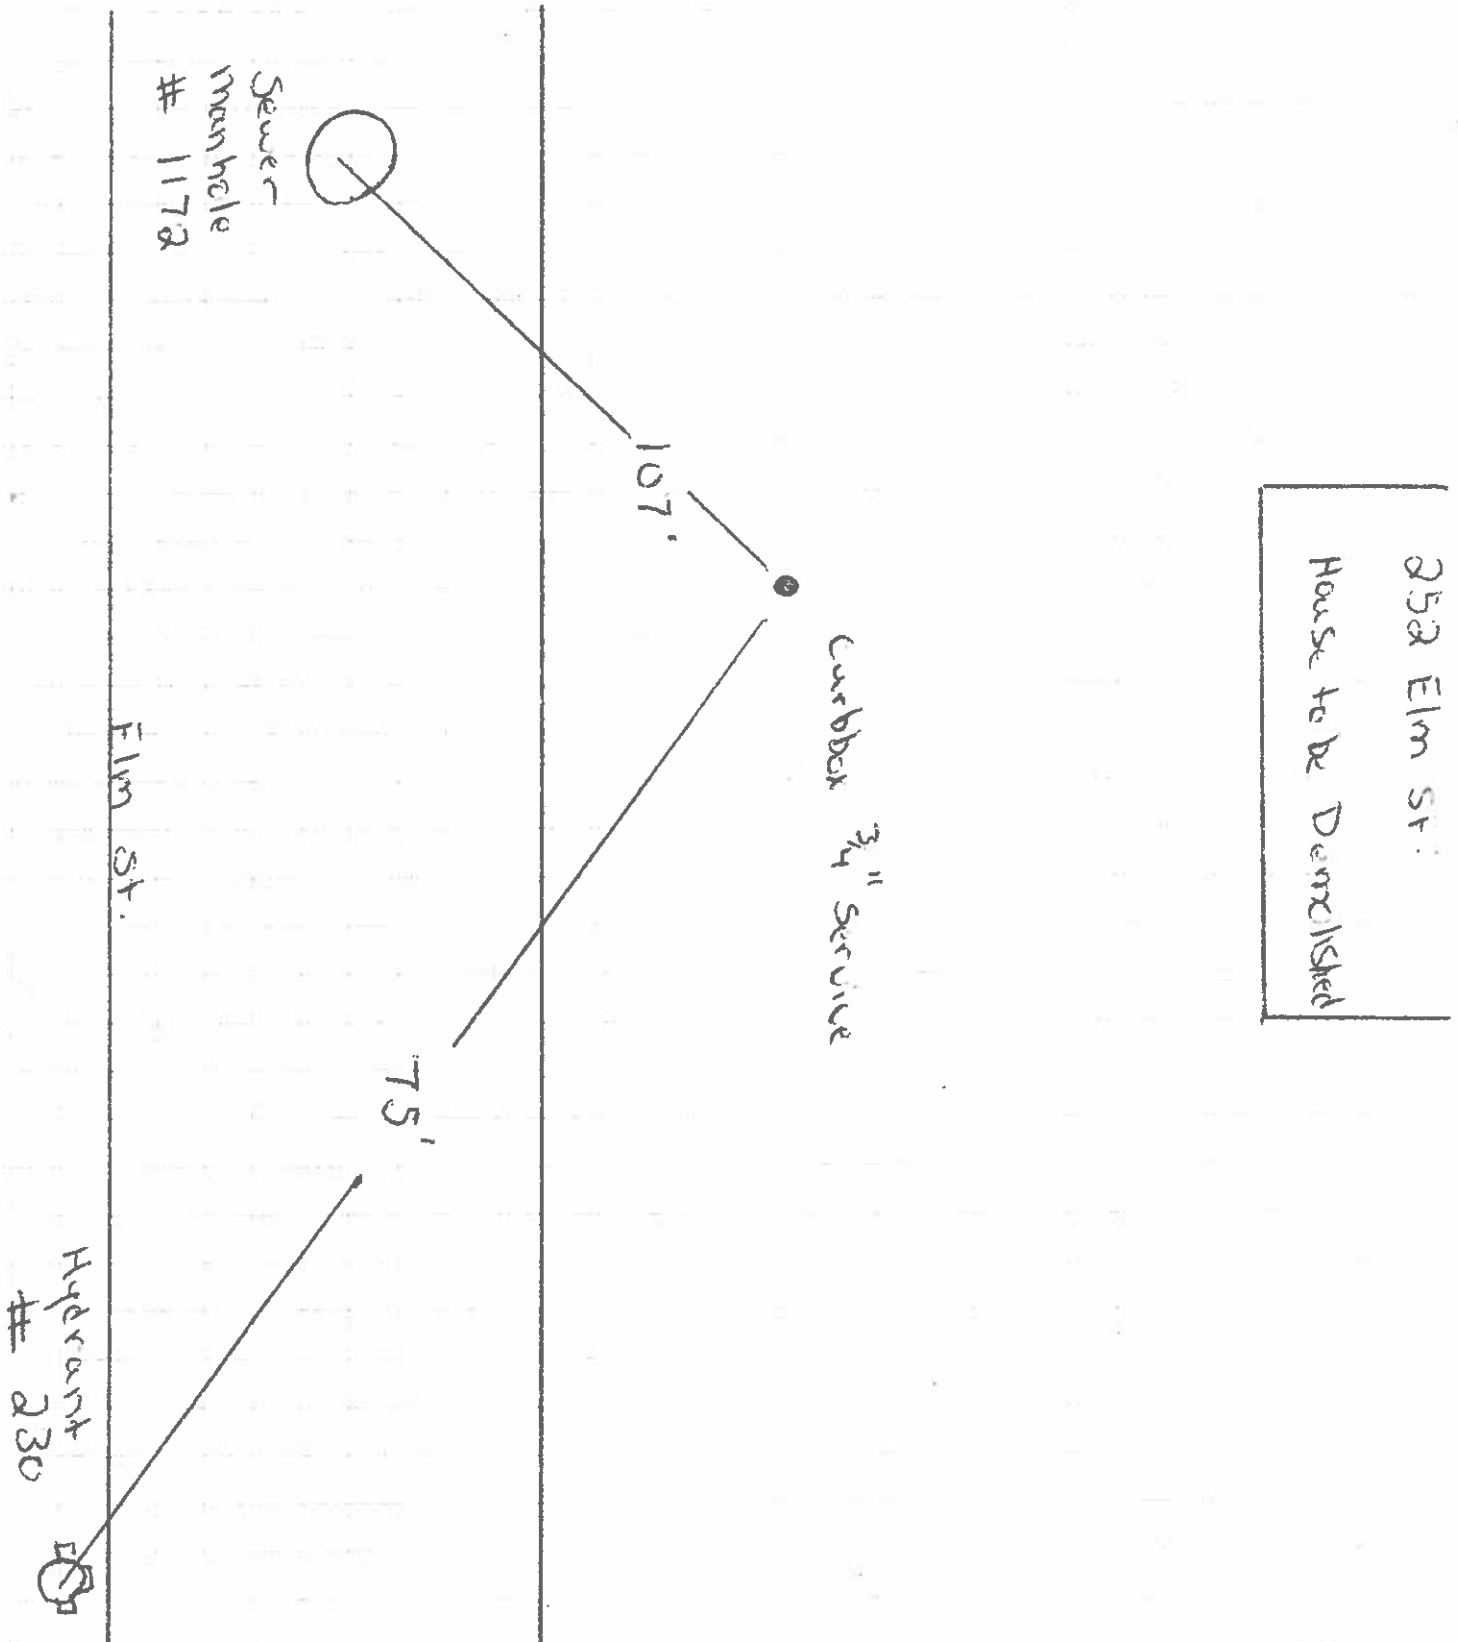

252 Elm St.
House to be Demolished