


## EUCLID AVENUE - #57

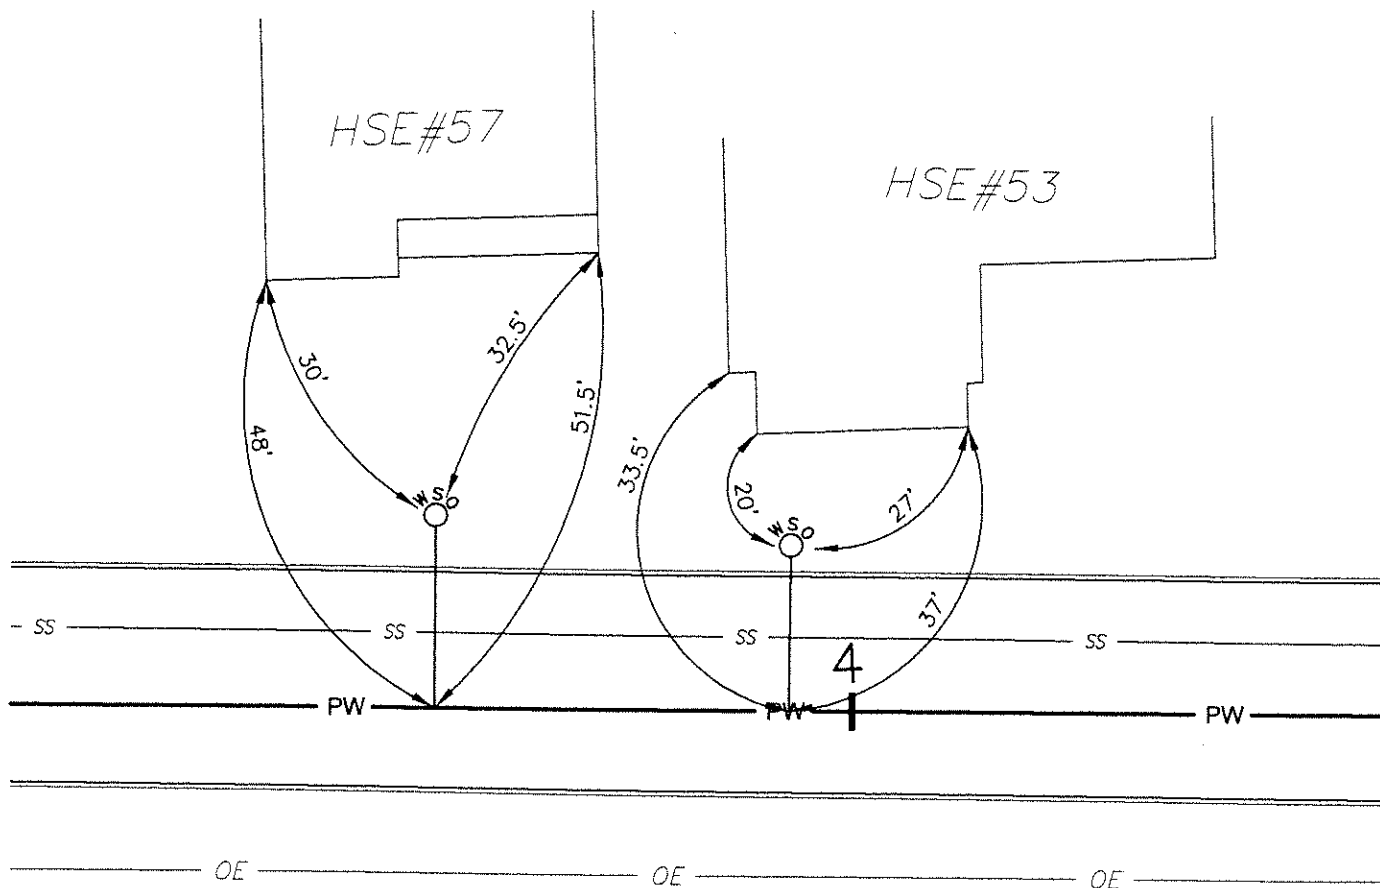

### HOUSE SERVICE INFORMATION:

DEPTH AT MAIN: 5.5'  
DEPTH AT PROPERTY LINE: UNKNOWN, CONNECTION MADE 2 FT. FROM THE  
MAIN AT THE TOWN'S REQUEST  
DATE INSTALLED: 11/19/04

PREPARED BY TIGHE & BOND