


EAST LONGMEADOW DEPARTMENT OF PUBLIC WORKS

Job: 5 Fern Glen ROAD
Sheet No: _____ of WATER
Calculated By: R2 Eyrat Date 11-13-17
Scale: _____

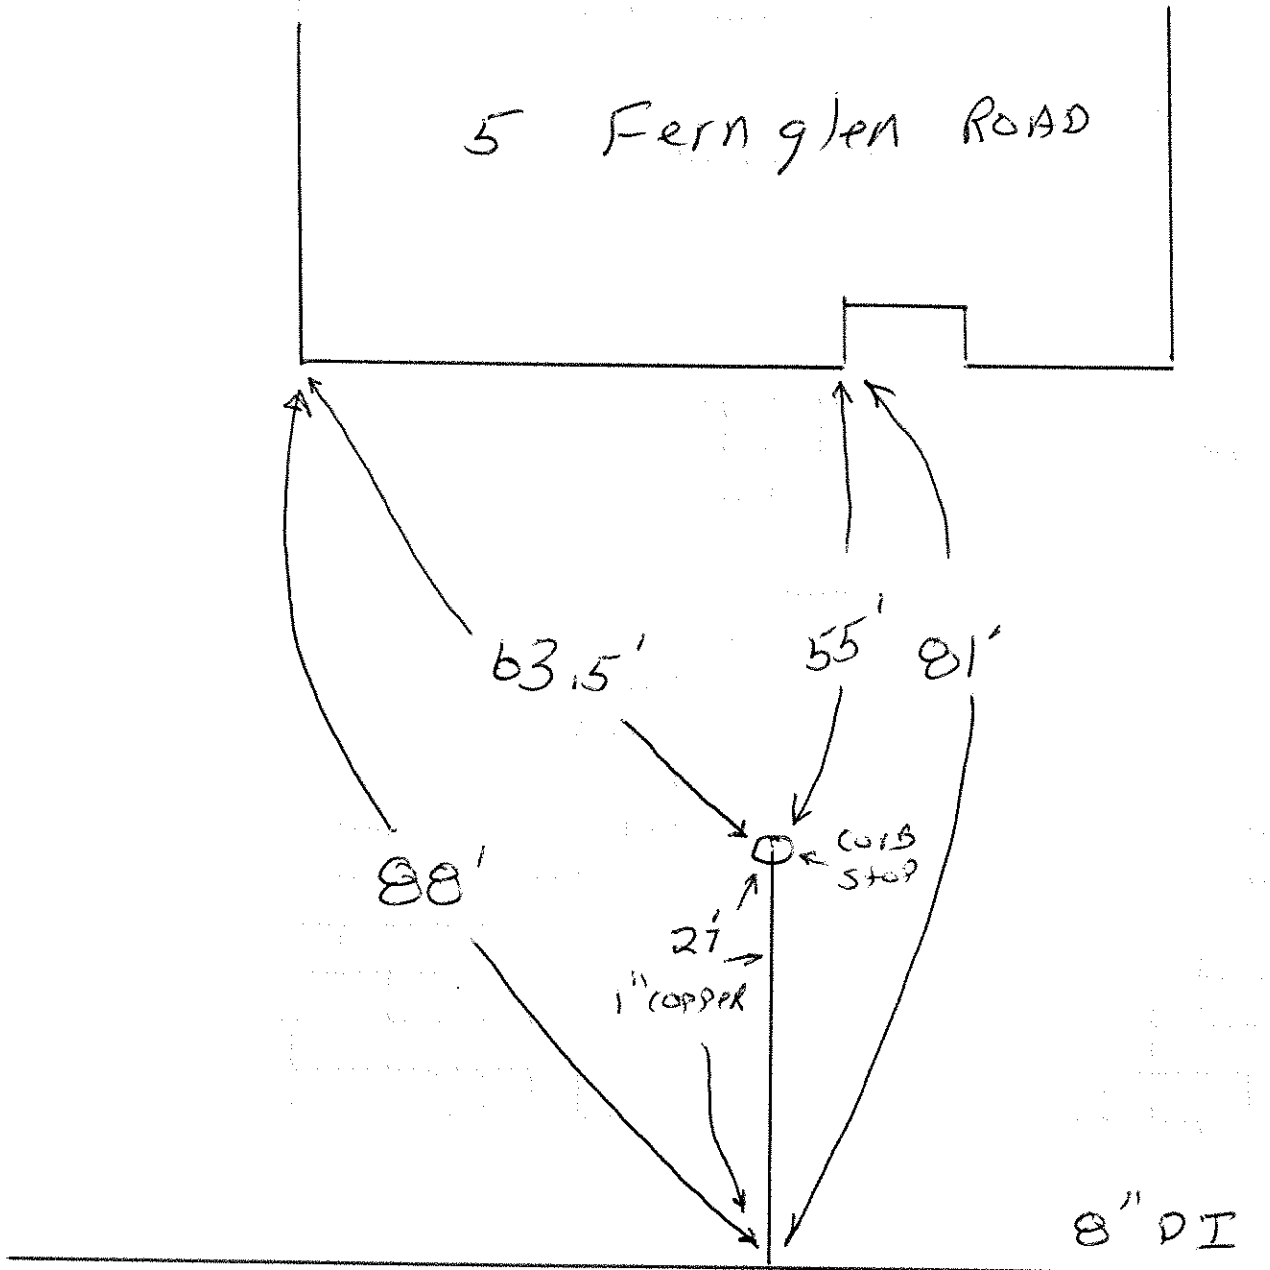

Fern Glen ROAD