


EAST LONGMEADOW DEPARTMENT OF PUBLIC WORKS

Job: 15 Fernglen Road

Sheet No: _____ of WATER

Calculated By: R2 Esposito Date 11-8-17

Scale: _____

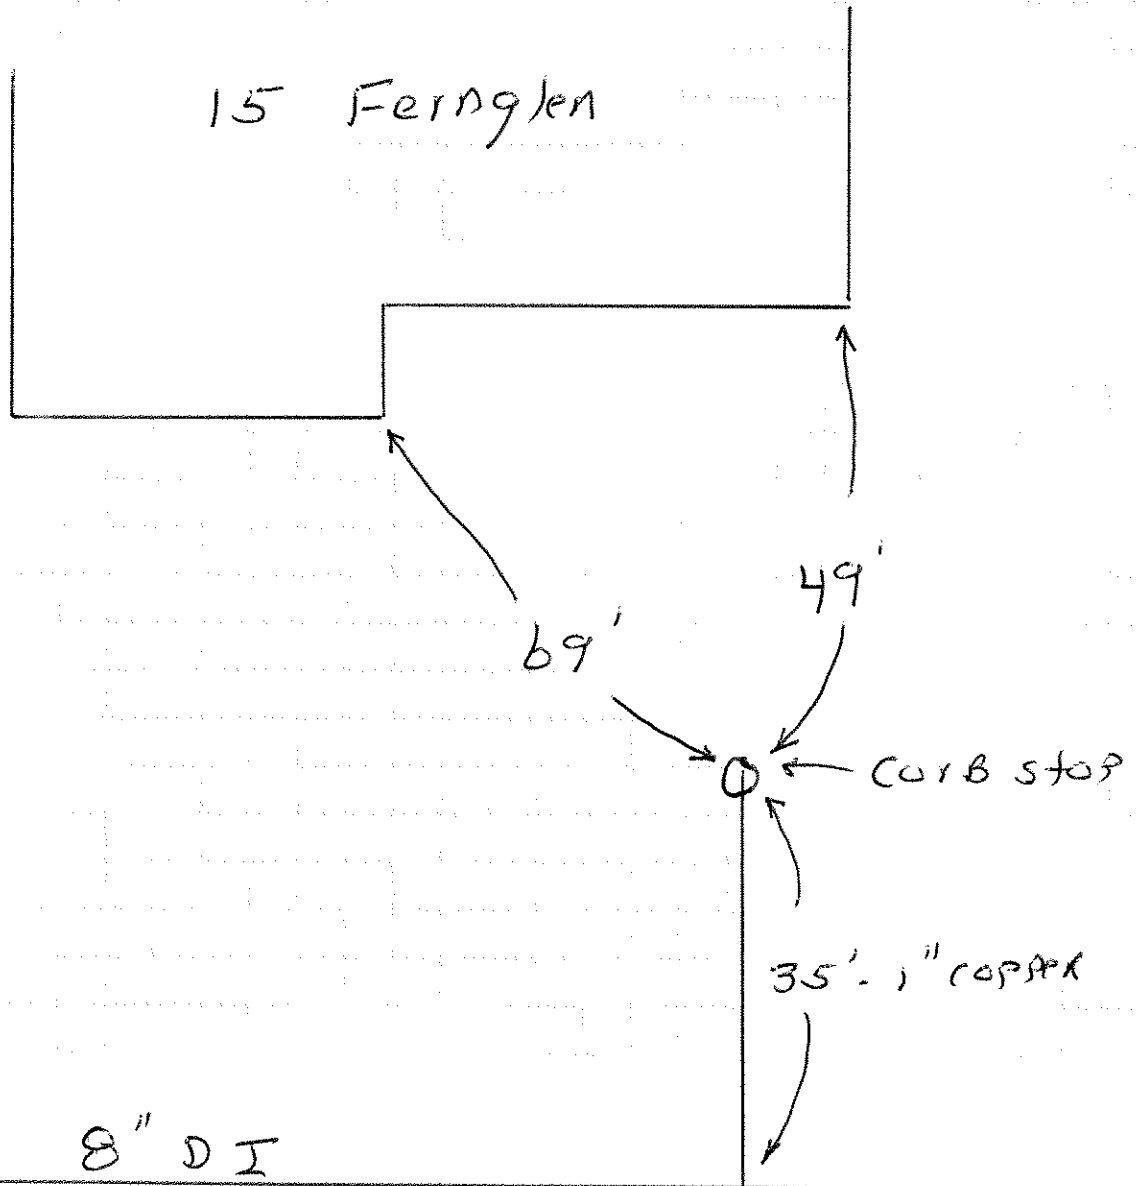

Fernglen Road