


NO. STREET

DATE INST.

MAKE:

SIZE

29 FISHER AVE.

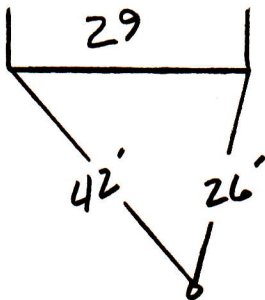

1" COPPER