

NO. STREET

DATE INST.

MAKE:

SIZE


41 FISHER AVE

3/18/02

BADGER

1"

41

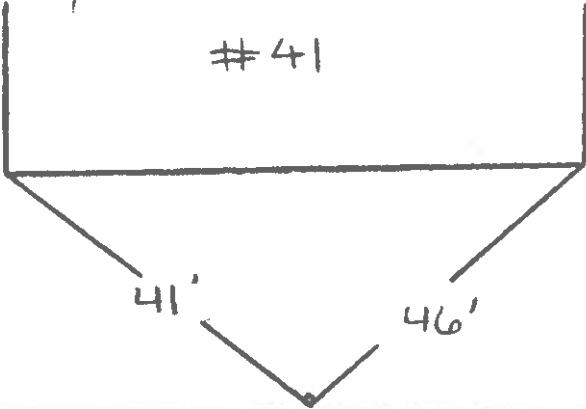

A hand-drawn diagram of a triangular lot. The top boundary is a horizontal line. From each end of this line, a vertical line extends upwards. The two vertical lines are connected by a horizontal line at the top, forming a rectangle. The text "# 41" is written in the center of this rectangle. From the bottom-left corner of the rectangle, a line extends downwards and to the right, labeled "41'". From the bottom-right corner of the rectangle, a line extends downwards and to the left, labeled "46'". These two lines meet at a point at the bottom, forming a triangle. The entire diagram is drawn with thick black lines.

41'

46'