

NO. STREET


DATE INST.

MAKE:

SIZE

16 FORBES HILL ROAD

5-23-12

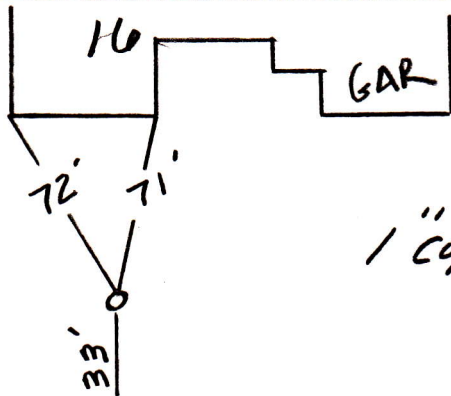

1" COPPER