


JOB NO.: E526

STREET ADDRESS: HSE#38 GERRARD AVENUE

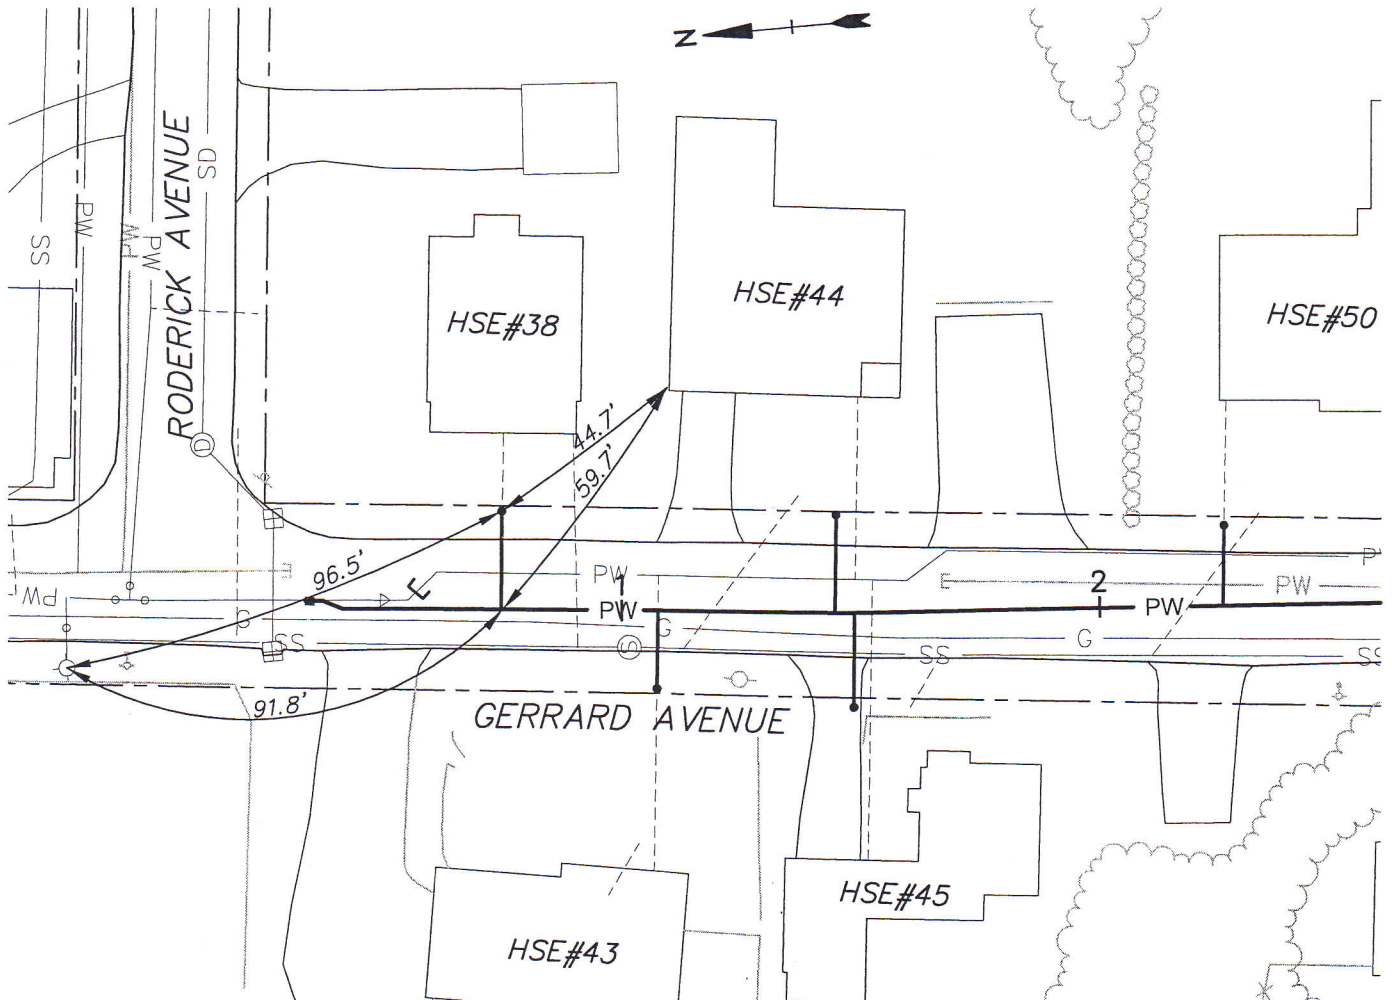

LOAM & SEED _____
BIT. DRIVEWAY _____
BIT. CURBS _____
BIT. SIDEWALK _____
CONC. CURB _____
CONC. SIDEWALK _____

SERVICE INSTALLED: 7-20-07
SIZE: 1"
MATERIAL: 1-CORP., 1-C. STOP WITH BOX
DEPTH AT MAIN: 5.0'
DEPTH AT CURB STOP: 5.0'
LENGTH OF Cu PIPE: 22.0'+1.5' = 23.5'