


JOB NO.: E526

STREET ADDRESS: HSE#43 GERRARD AVENUE

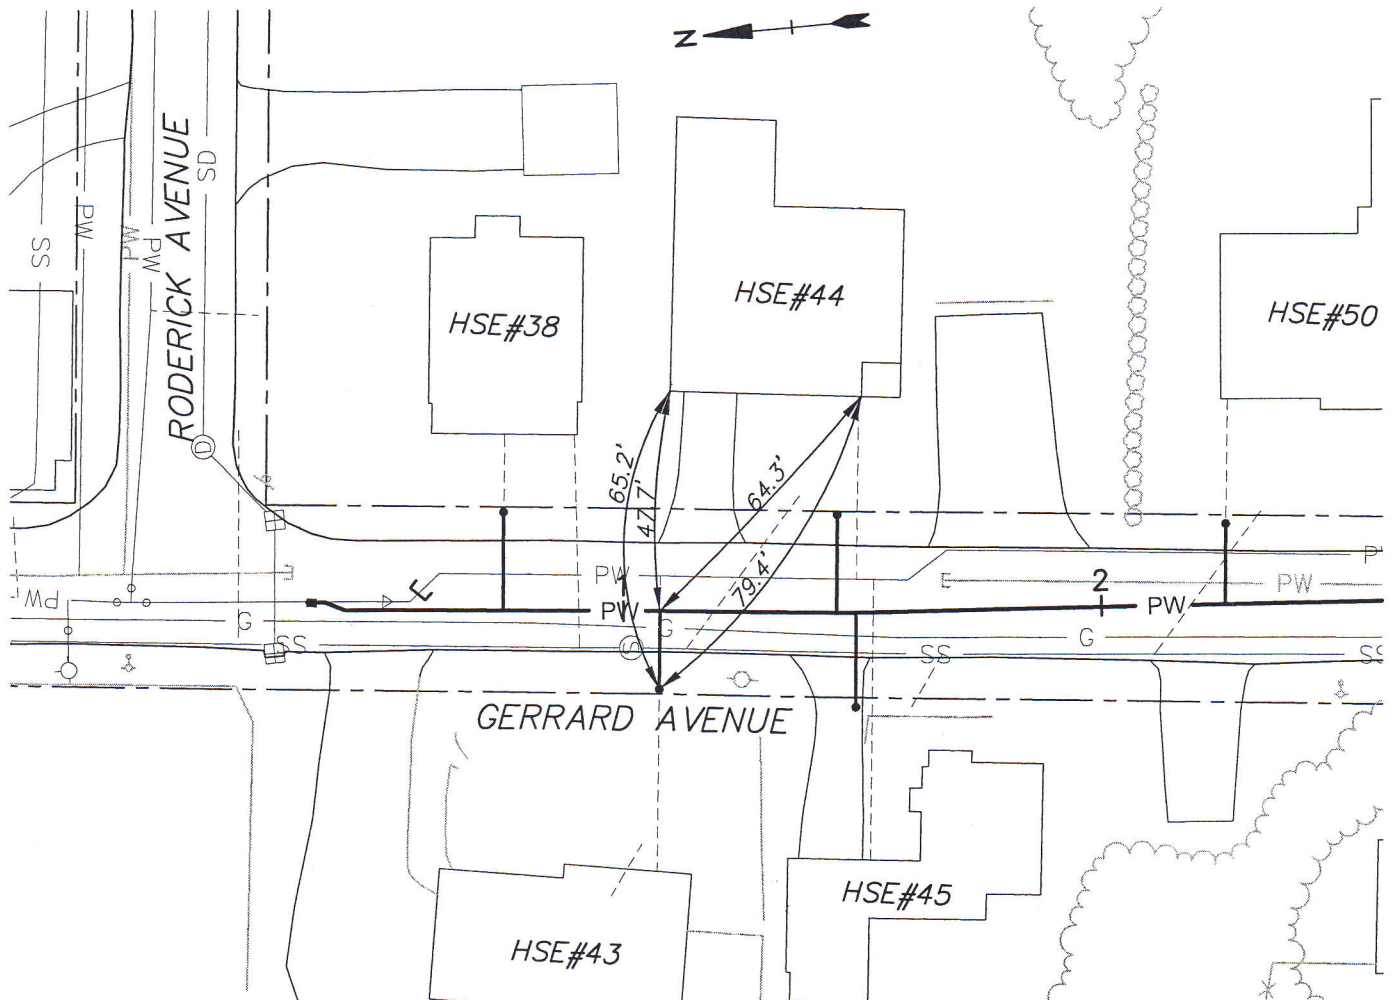

LOAM & SEED 12'x4'  
BIT. DRIVEWAY \_\_\_\_\_  
BIT. CURBS \_\_\_\_\_  
BIT. SIDEWALK \_\_\_\_\_  
CONC. CURB \_\_\_\_\_  
CONC. SIDEWALK \_\_\_\_\_

SERVICE INSTALLED: 7-17-07  
SIZE: 1"  
MATERIAL: 1-CORP., 1-C. STOP WITH BOX  
DEPTH AT MAIN: 5.5'  
DEPTH AT CURB STOP: 5.5'  
LENGTH OF Cu PIPE: 19.0'+1.0' = 20'