


STREET ADDRESS: *HSE#44 GERRARD AVENUE*

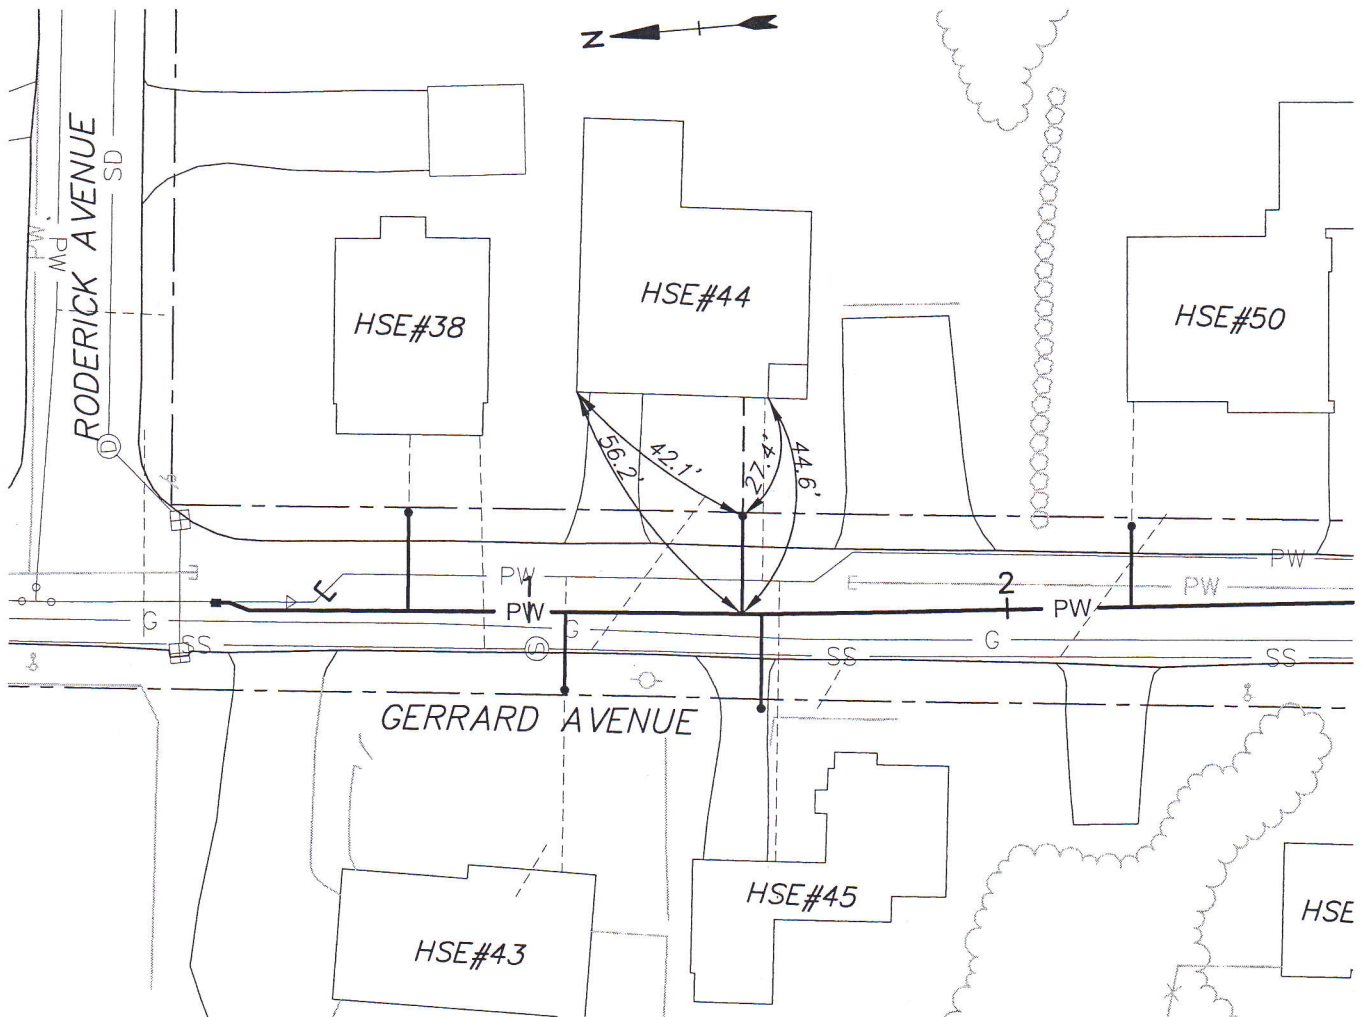

LOAM & SEED	8.5'x4'
BIT. DRIVEWAY	
BIT. CURBS	
BIT. SIDEWALK	
CONC. CURB	
CONC. SIDEWALK	

SERVICE INSTALLED: 7-18-07

SIZE: 1"

MATERIAL: 1-CORP., 1-C. STOP WITH BOX

DEPTH AT MAIN: 5.3'

DEPTH AT CURB STOP: 5.4'

LENGTH OF Cu PIPE: 19.0' + 1.0' = 20'