


44 GERBARD AVENUE

7-18-2007

#44

1" CTSP
m-c

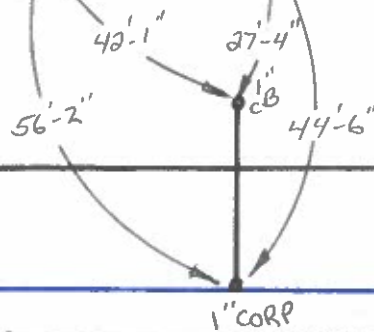

8" DI MAIN

1" CORP