


54 GERRARD AVENUE

7-18-2007

#54

1" CTSP
M-C

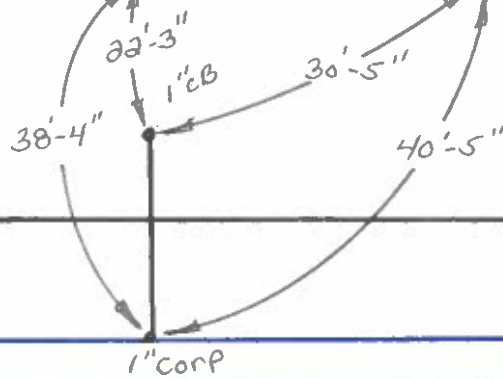

8" DI