


STREET ADDRESS: HSE#61 GERRARD AVENUE

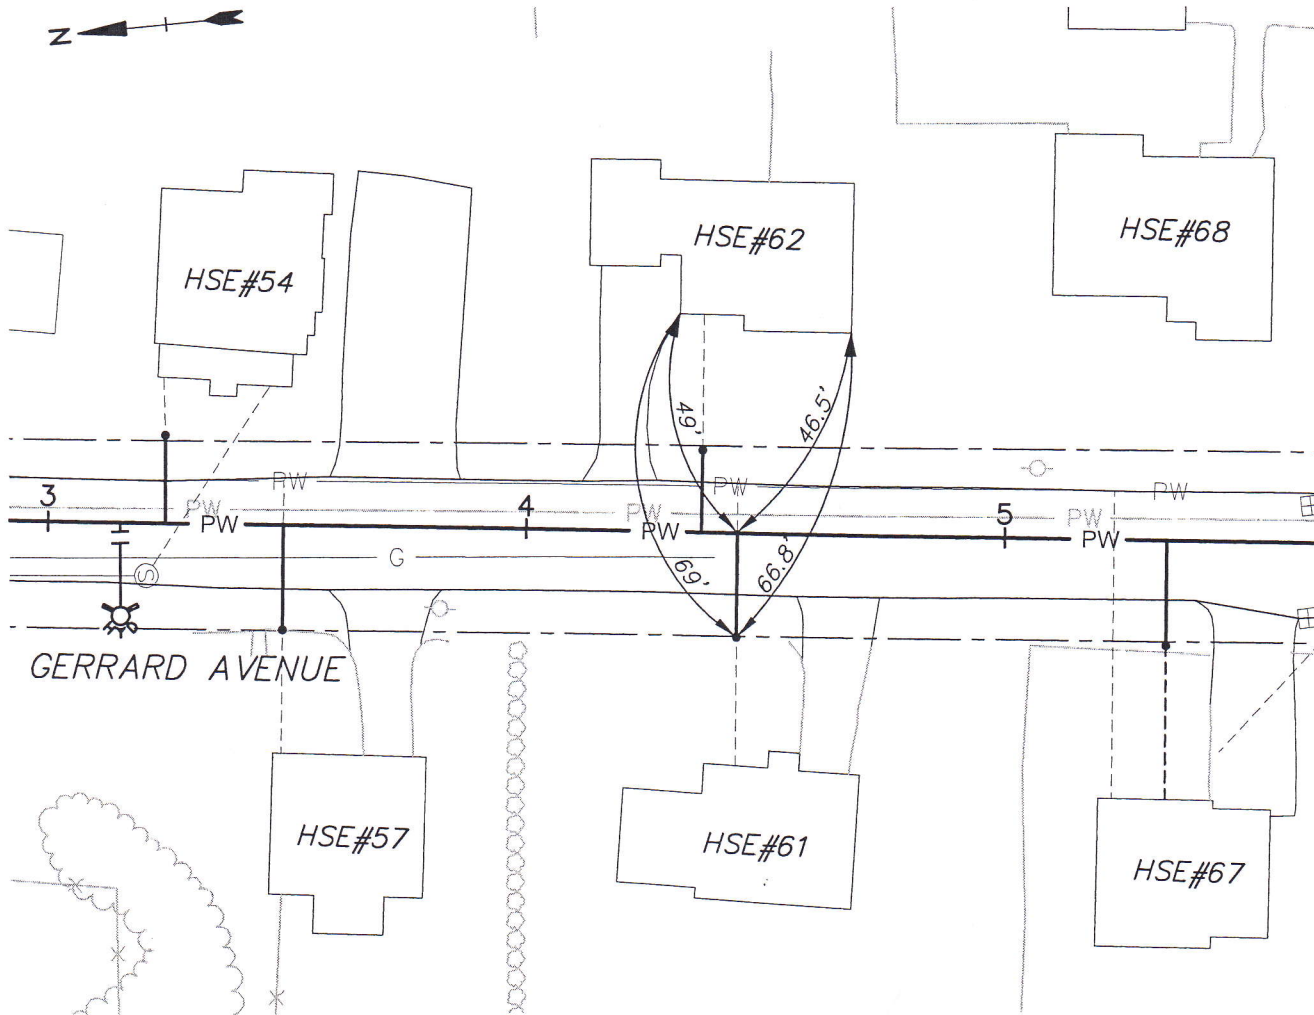

LOAM & SEED _____

BIT. DRIVEWAY _____

BIT. CURBS _____

BIT. SIDEWALK _____

CONC. CURB _____

CONC. SIDEWALK _____

SERVICE INSTALLED: 7-19-07

SIZE: _____ 1"

MATERIAL: 1-CORP., 1-C. STOP WITH BOX

DEPTH AT MAIN: 4.9'

DEPTH AT CURB STOP: 5.0'

LENGTH OF Cu PIPE: $\underline{22.5' + 1.5' = 24'}$