


GERRARD STREET - #79

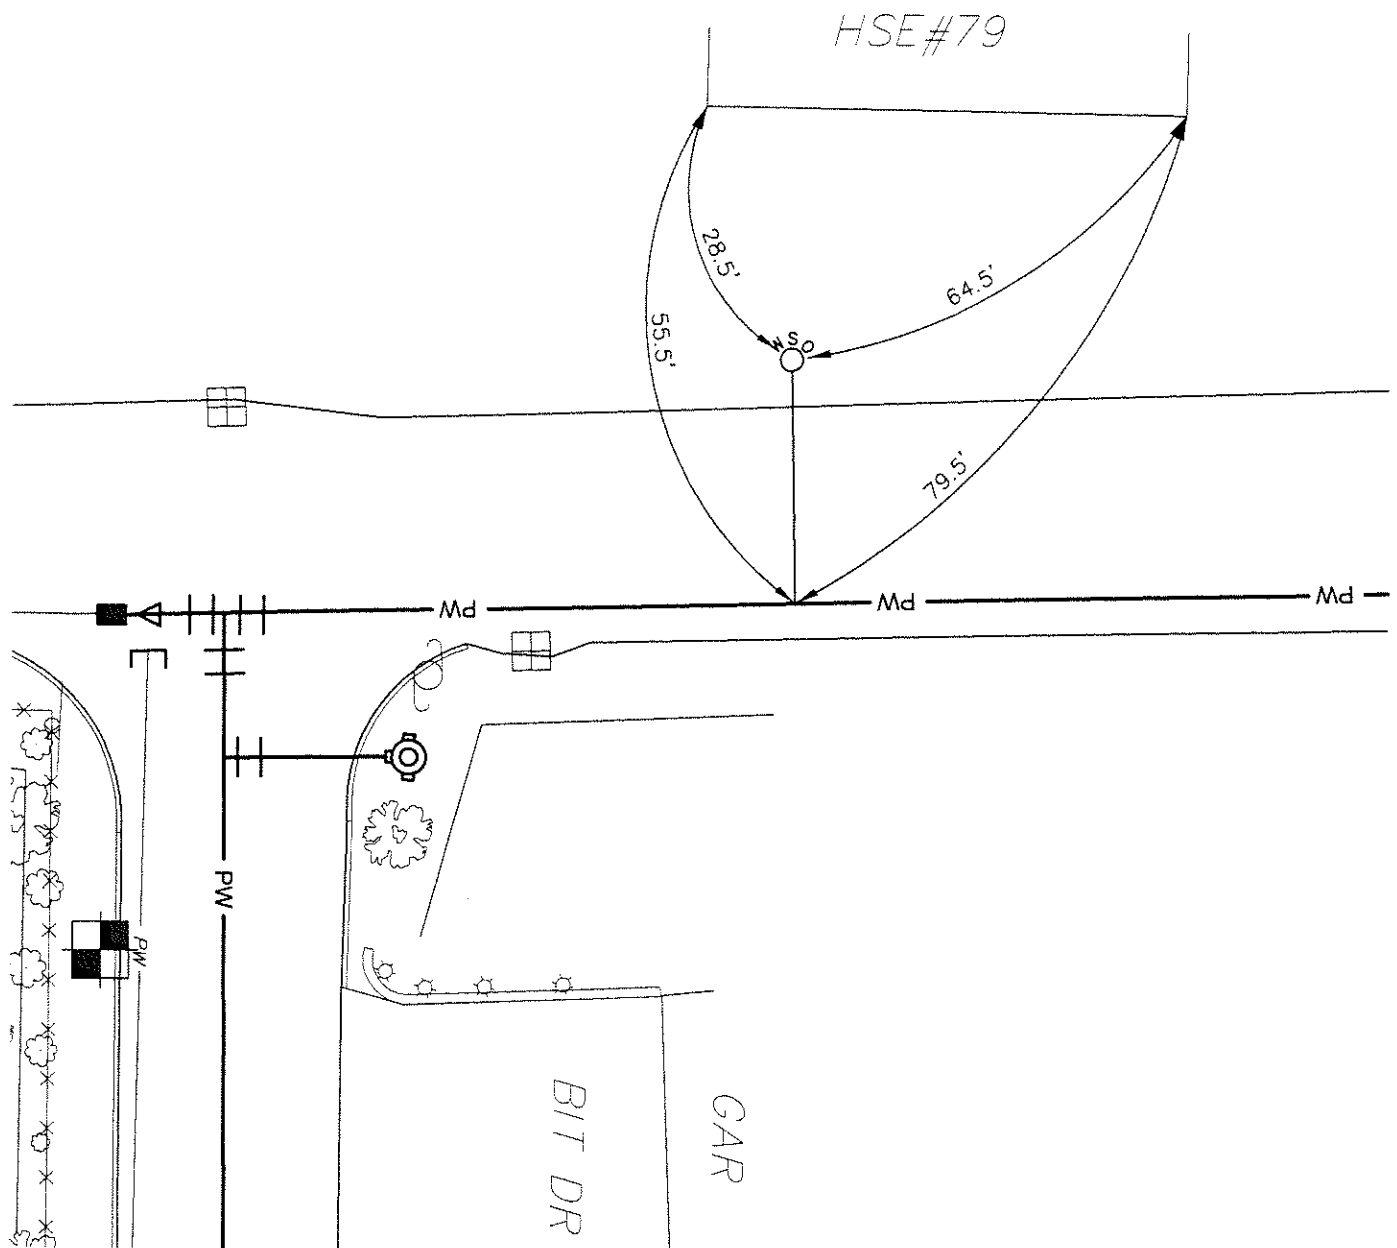

HOUSE SERVICE INFORMATION:

DEPTH AT MAIN: 5.5'
DEPTH AT PROPERTY LINE: 6'
DATE INSTALLED: 11/18/04

PREPARED BY TIGHE & BOND