


79 GERRARD AVENUE

11-18-2004

1" C+SP
M-C

#79

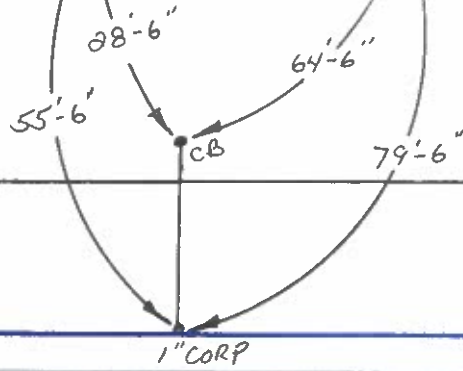

8" DI