


JOB NO.: E526

STREET ADDRESS: HSE#89 GERRARD AVENUE

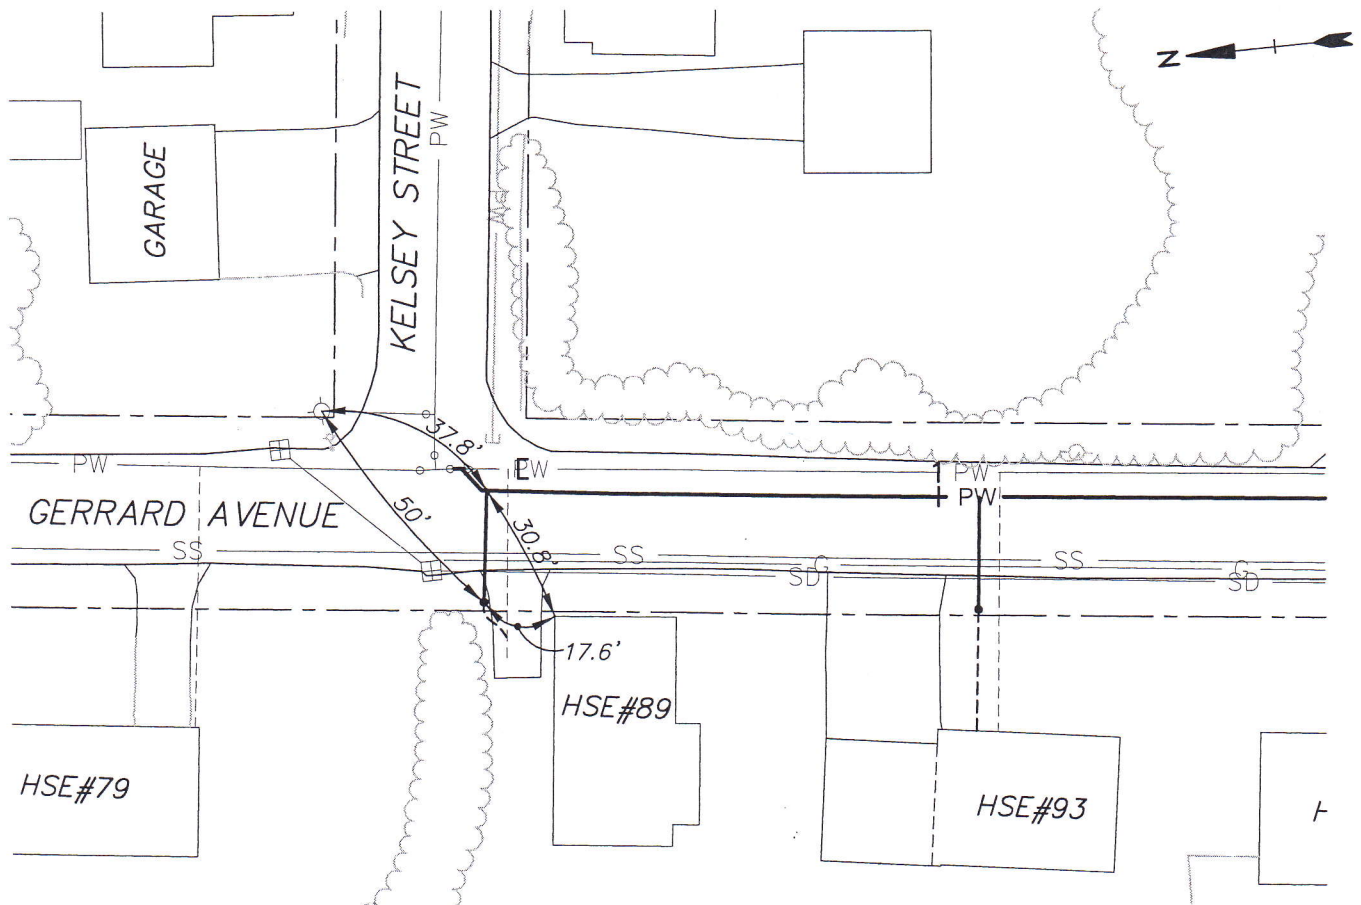

LOAM & SEED 6.5'x4.5'
BIT. DRIVEWAY
BIT. CURBS
BIT. SIDEWALK
CONC. CURB
CONC. SIDEWALK

22.2'x5.0'

SERVICE INSTALLED: 8-20-07
SIZE: 1"
MATERIAL: 1-CORP., 1-C. STOP WITH BOX
DEPTH AT MAIN: 4.5'
DEPTH AT CURB STOP: 5.0'
LENGTH OF Cu PIPE: 23'+1.0=24'