


JOB NO.: E526

STREET ADDRESS: HSE#93 GERRARD AVENUE

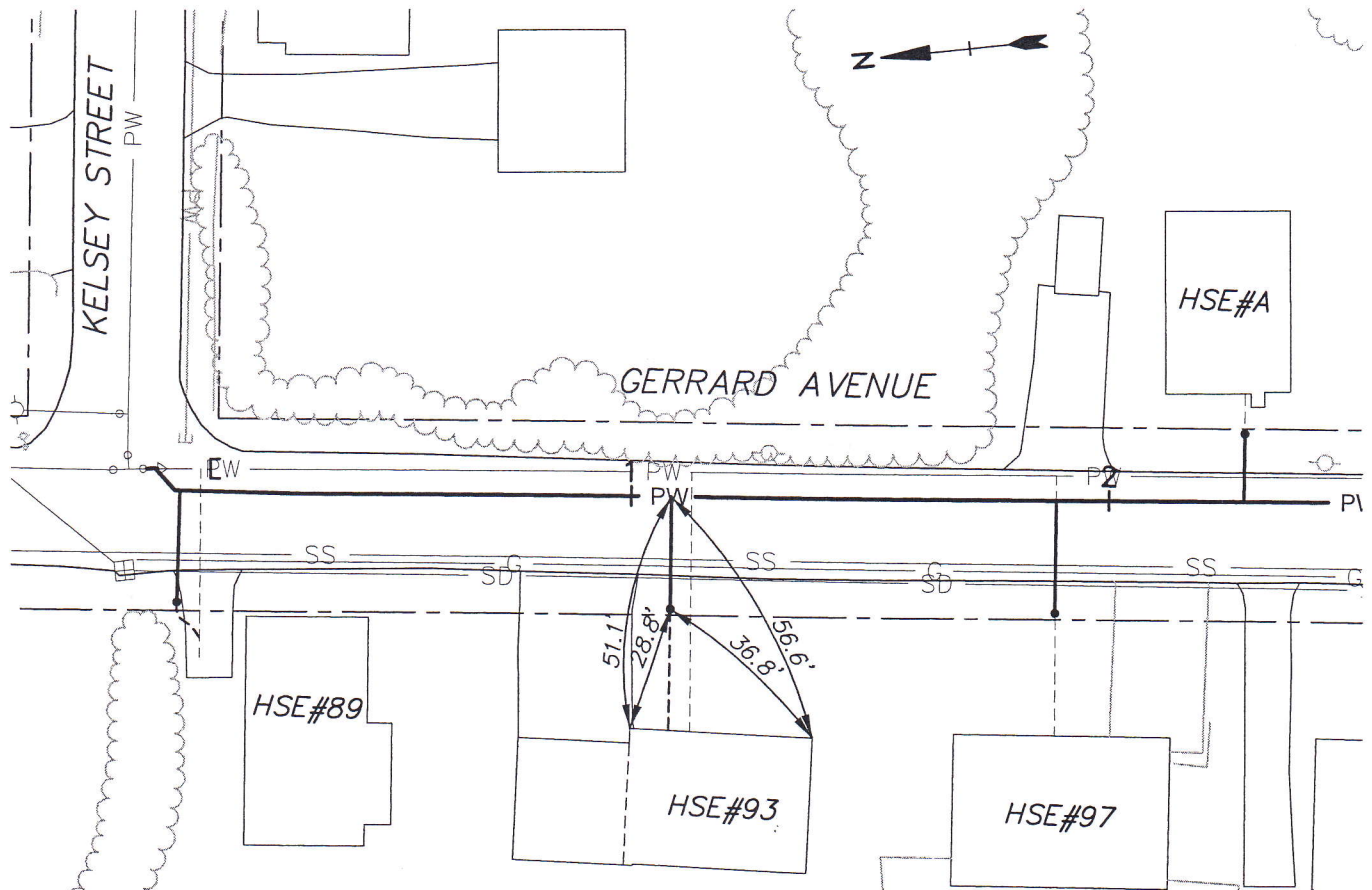

LOAM & SEED	9.5'x4'
BIT. DRIVEWAY	
BIT. CURBS	4.5'
BIT. SIDEWALK	
CONC. CURB	
CONC. SIDEWALK	

19.7'x4.4'

SERVICE INSTALLED:	8-20-07
SIZE:	1"
MATERIAL:	1-CORP., 1-C. STOP WITH BOX
DEPTH AT MAIN:	5.0'
DEPTH AT CURB STOP:	5.0'
LENGTH OF Cu PIPE:	24'+1.0'=25'