


JOB NO.: E526

STREET ADDRESS: *HSE#97 GERRARD AVENUE*

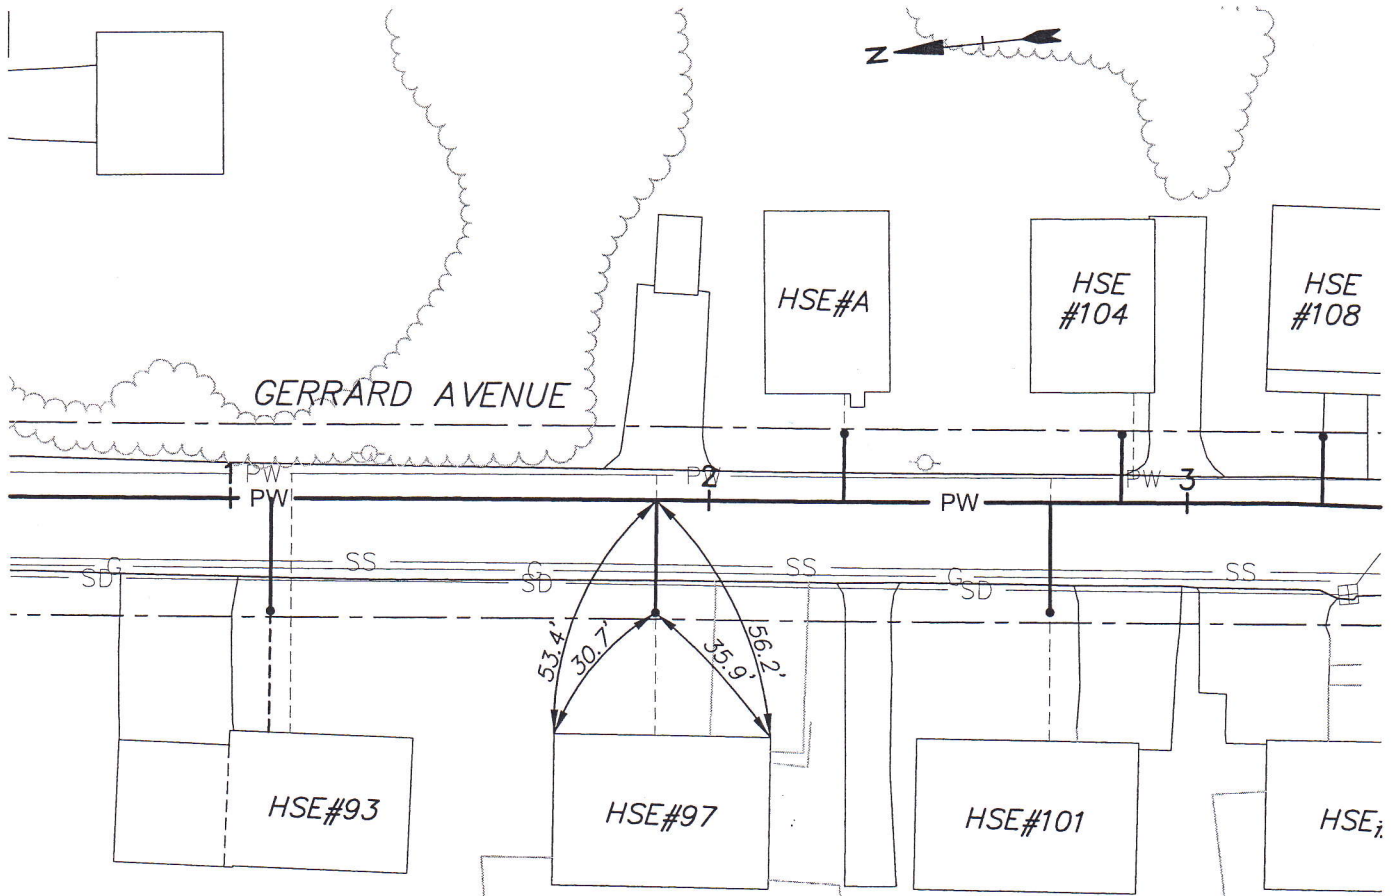

LOAM & SEED	16'x5'
BIT. DRIVEWAY	
BIT. CURBS	10.0'
BIT. SIDEWALK	
CONC. CURB	
CONC. SIDEWALK	

19.3'x4.6'

SERVICE INSTALLED: 8-20-07

SIZE: 1"

MATERIAL: 1-CORP., 1-C. STOP WITH BOX

DEPTH AT MAIN: 4.8'

DEPTH AT CURB STOP: 4.8'

LENGTH OF Cu PIPE: 25.5'+5.0'=30.5'