


97 GERRARD AVENUE

8-20-2007

#97

1"ctsp
M-C

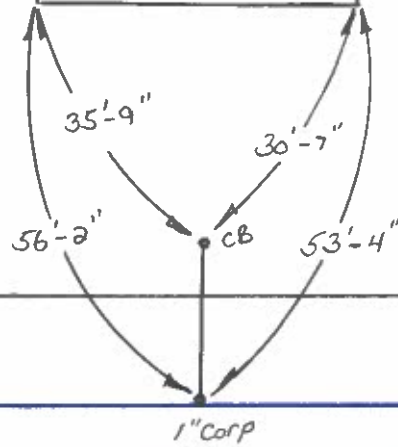

8"DI