


JOB NO.: E526

STREET ADDRESS: HSE#101 GERRARD AVENUE

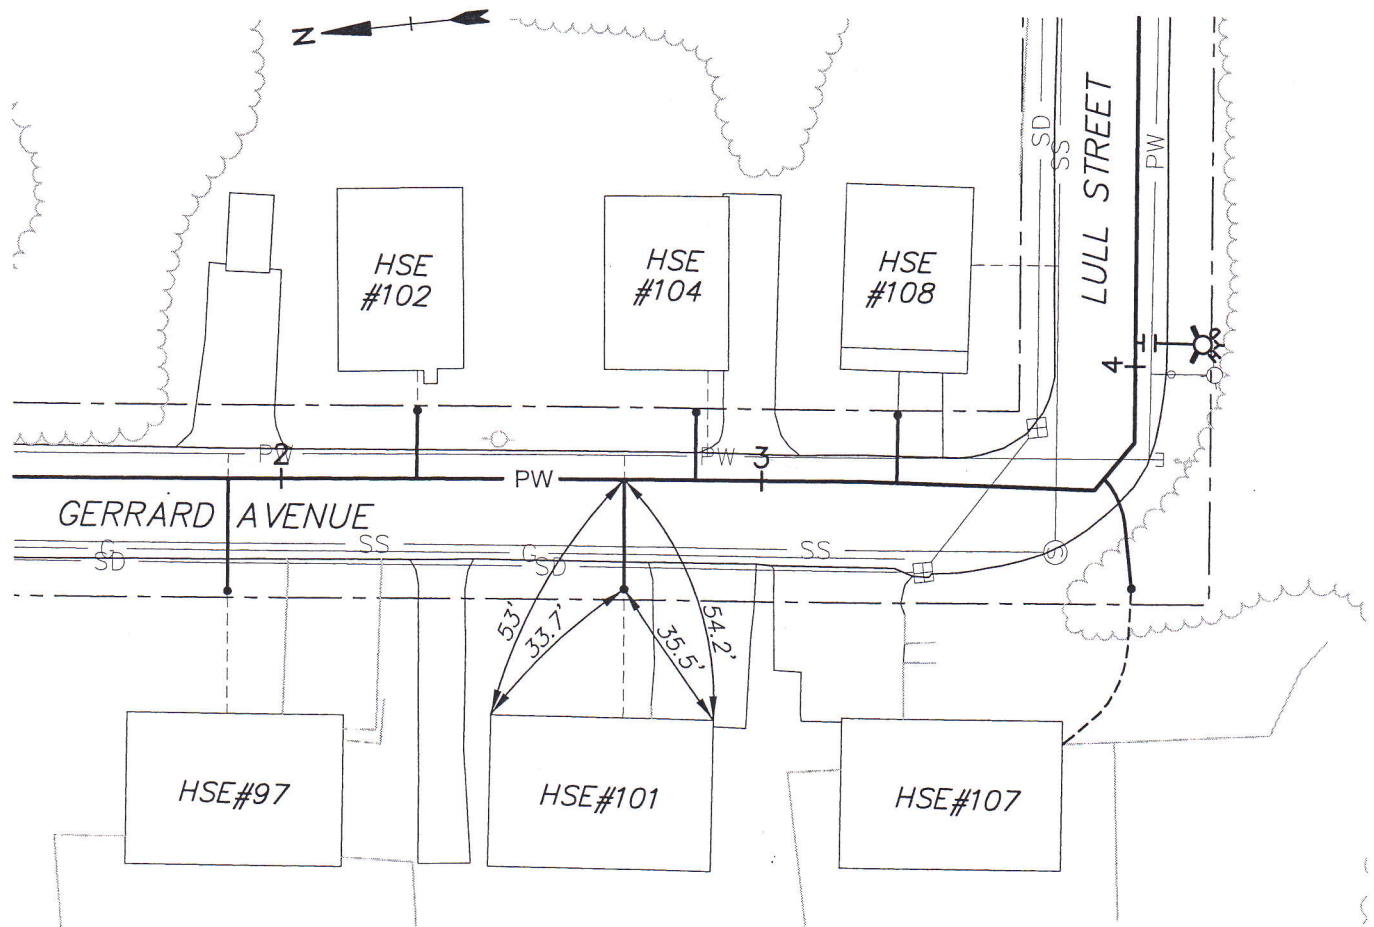

LOAM & SEED _____ 10.5'x4.0'
BIT. DRIVEWAY _____
BIT. CURBS _____ 4.7'
BIT. SIDEWALK _____
CONC. CURB _____
CONC. SIDEWALK _____

19.2'x3.9'

SERVICE INSTALLED: 8-20-07
SIZE: 1"
MATERIAL: 1-CORP., 1-C. STOP WITH BOX
DEPTH AT MAIN: 4.8'
DEPTH AT CURB STOP: 5.0'
LENGTH OF Cu PIPE: 22.5'+0.5'=23'