


101 GERRARD AVENUE

8-20-2007

#101

1" ctsP
m-c

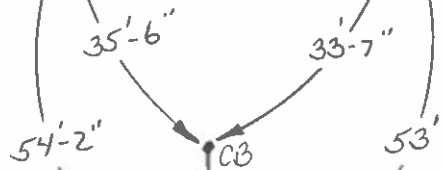

CB

8" DI

1" Corp