


JOB NO.: E526

STREET ADDRESS: HSE#102 GERRARD AVENUE

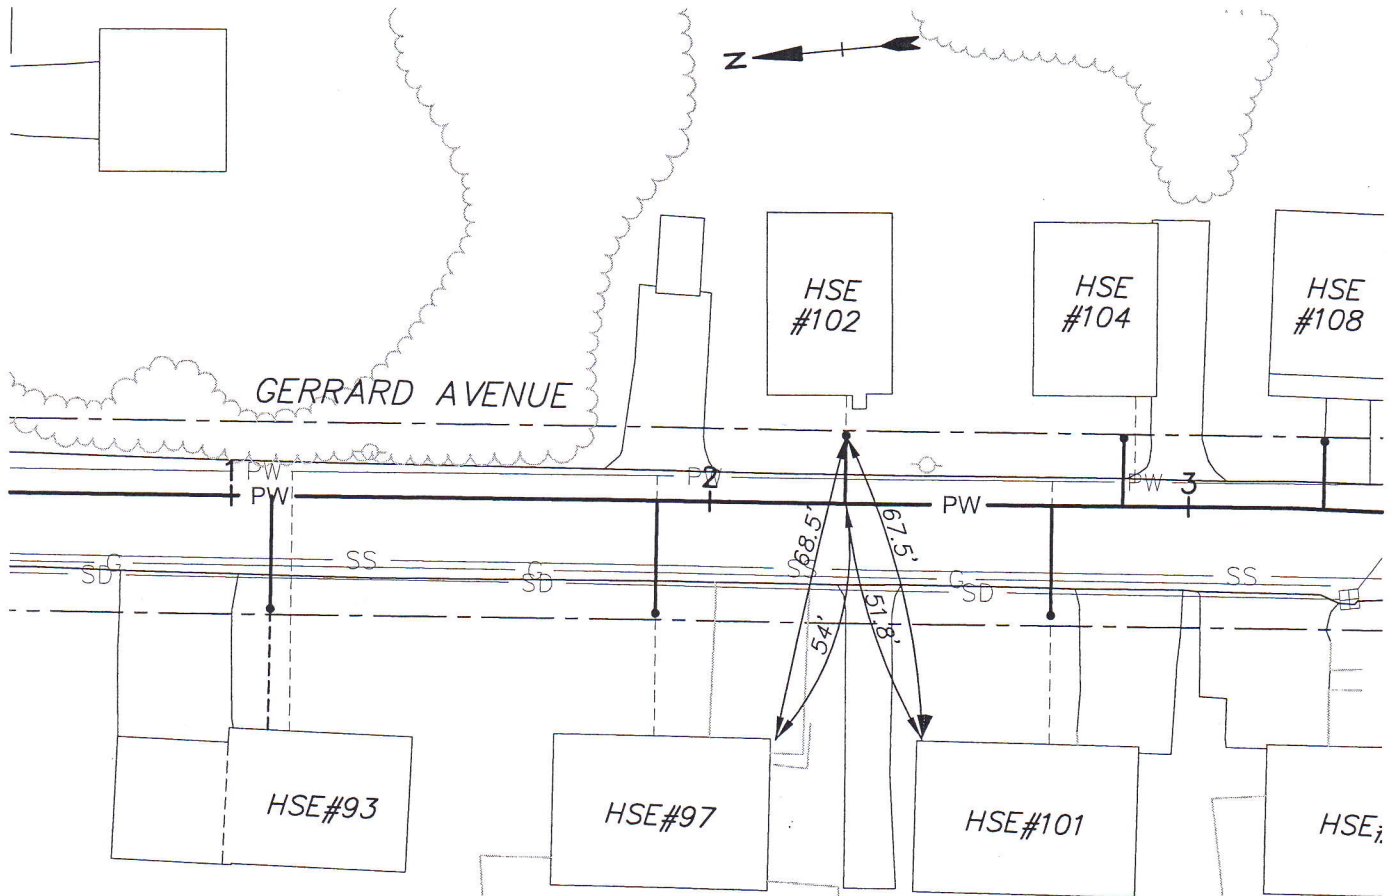

LOAM & SEED 9.5'x3.5'
BIT. DRIVEWAY _____
BIT. CURBS 5.5'
BIT. SIDEWALK _____
CONC. CURB _____
CONC. SIDEWALK _____

10.3'x4.4'

SERVICE INSTALLED: 8-21-07
SIZE: 1"
MATERIAL: 1-CORP., 1-C. STOP WITH BOX
DEPTH AT MAIN: 5.0'
DEPTH AT CURB STOP: 5.0'
LENGTH OF Cu PIPE: 15'+1.0'=16'