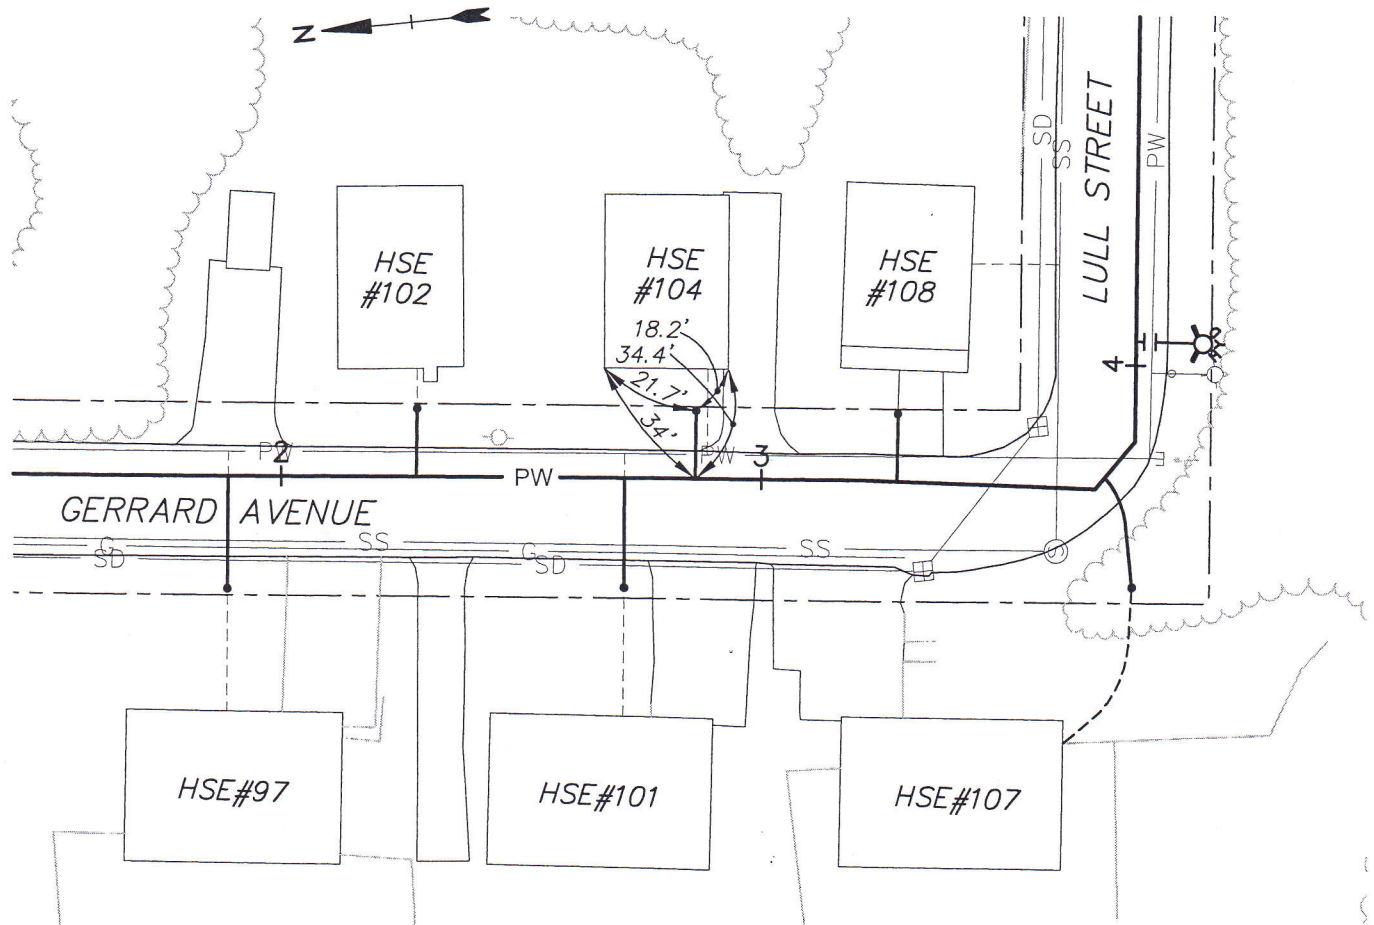


STREET ADDRESS: HSE#104 GERRARD AVENUE

LOAM & SEED	<u>9.0'x4.5'</u>
BIT. DRIVEWAY	<u> </u>
BIT. CURBS	<u>3.1'</u>
BIT. SIDEWALK	<u> </u>
CONC. CURB	<u> </u>
CONC. SIDEWALK	<u> </u>
TRENCH	<u>12.0x3.2'</u>

SERVICE INSTALLED:	<u>8-21-07</u>
SIZE:	<u>1"</u>
MATERIAL:	<u>1-CORP., 1-C. STOP WITH BOX</u>
DEPTH AT MAIN:	<u>5.0'</u>
DEPTH AT CURB STOP:	<u>4.5'</u>
LENGTH OF Cu PIPE:	<u>18.0'+1.0'=19'</u>