




EAST LONGMEADOW DEPARTMENT OF PUBLIC WORKS

Job: GRALIA DRIVE Water MAIN by TOWN DPW

Sheet No: NEW 8" DI MAIN of _____

Calculated By: NEW 1" SERVICES M-C Date EARLY 2000's

Scale: _____

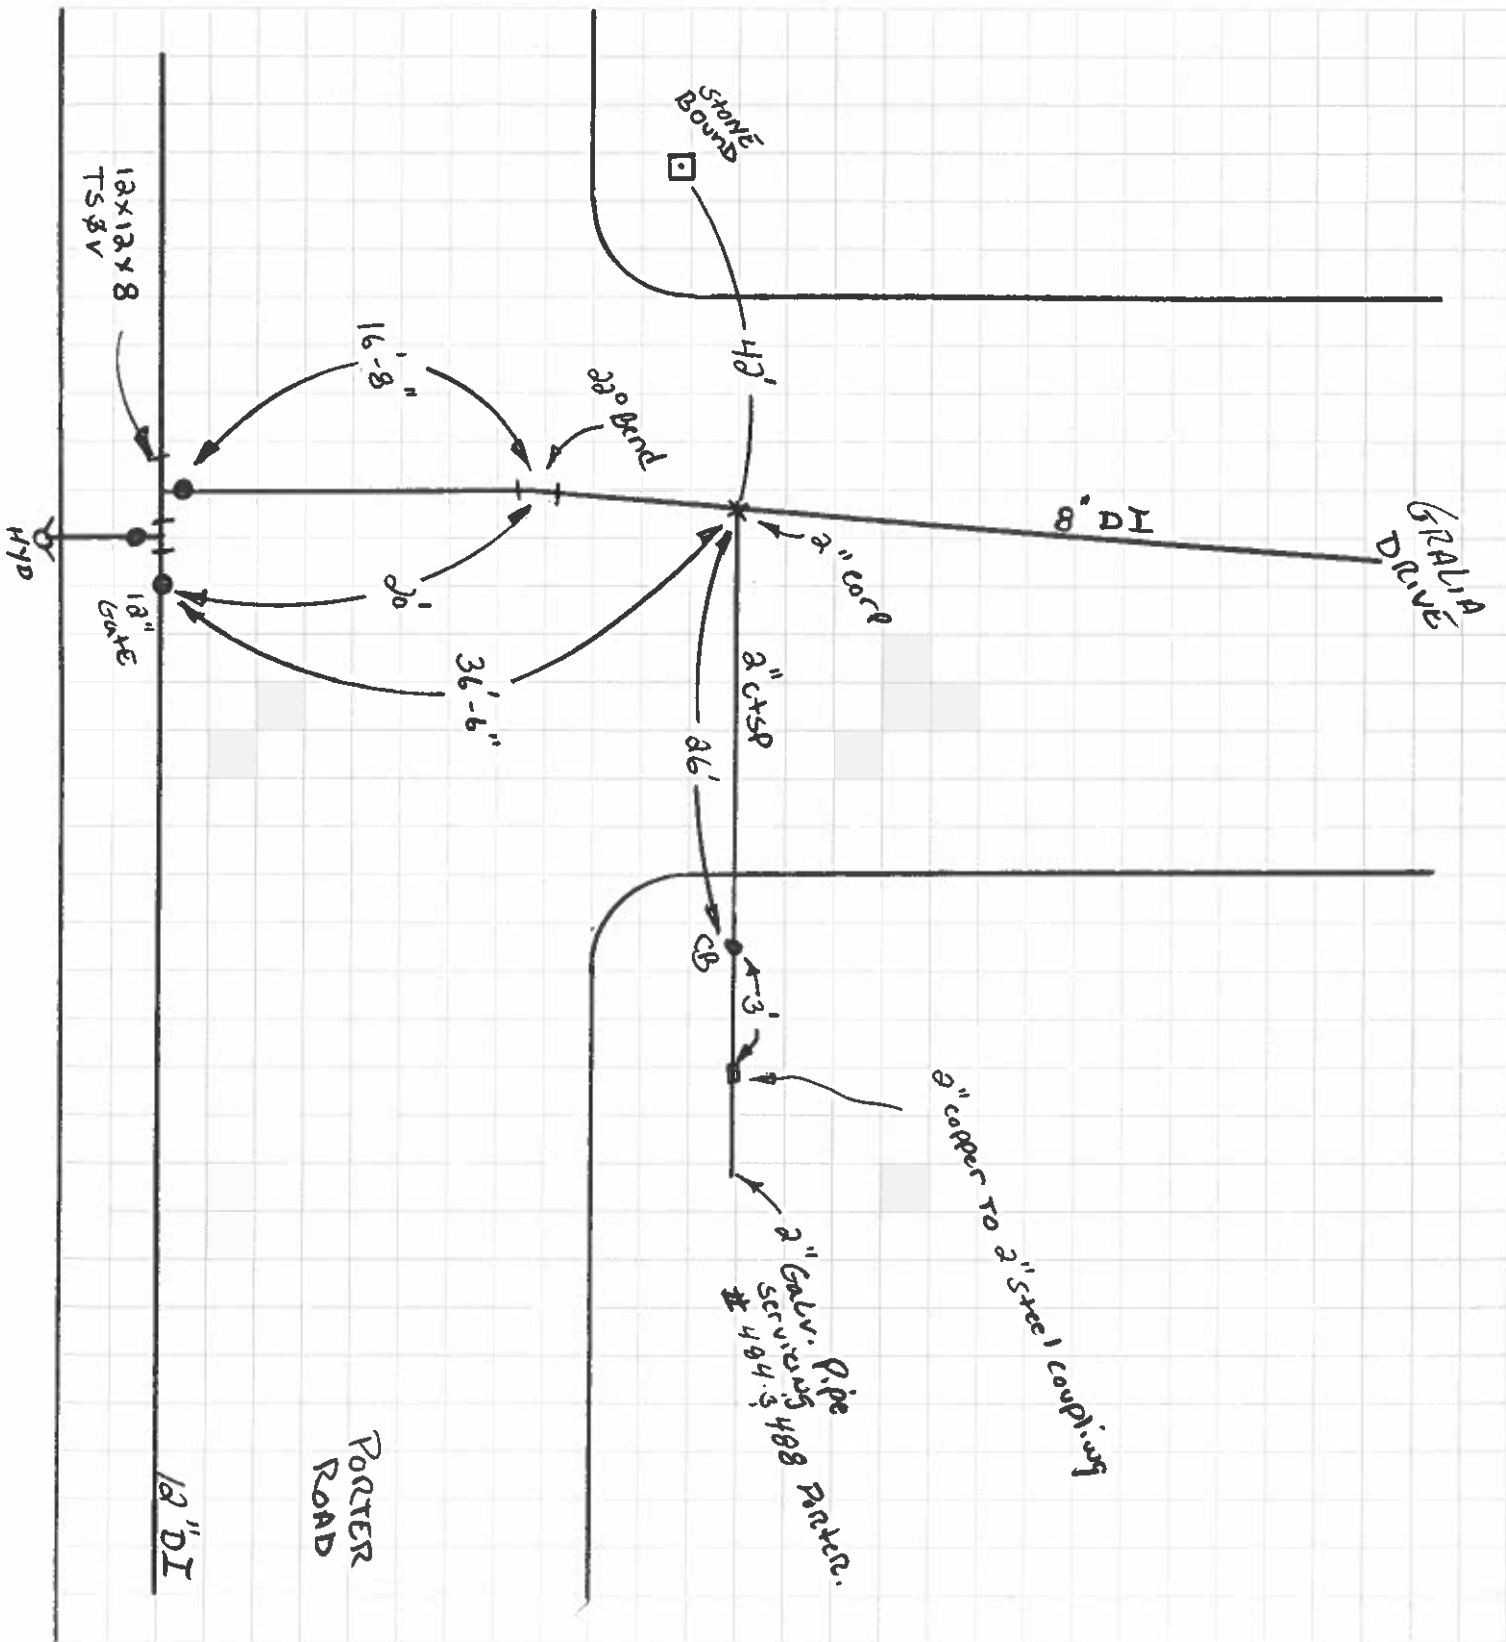



EAST LONGMEADOW DEPARTMENT OF PUBLIC WORKS

Job: Gratia Drive Water MAIN by TOWN DPW

Sheet No: New 8" DI MAIN of _____

Calculated By: New 1" Services m-c Date Early 2000's

Scale: _____

