


# GREENACRE LANE - #3

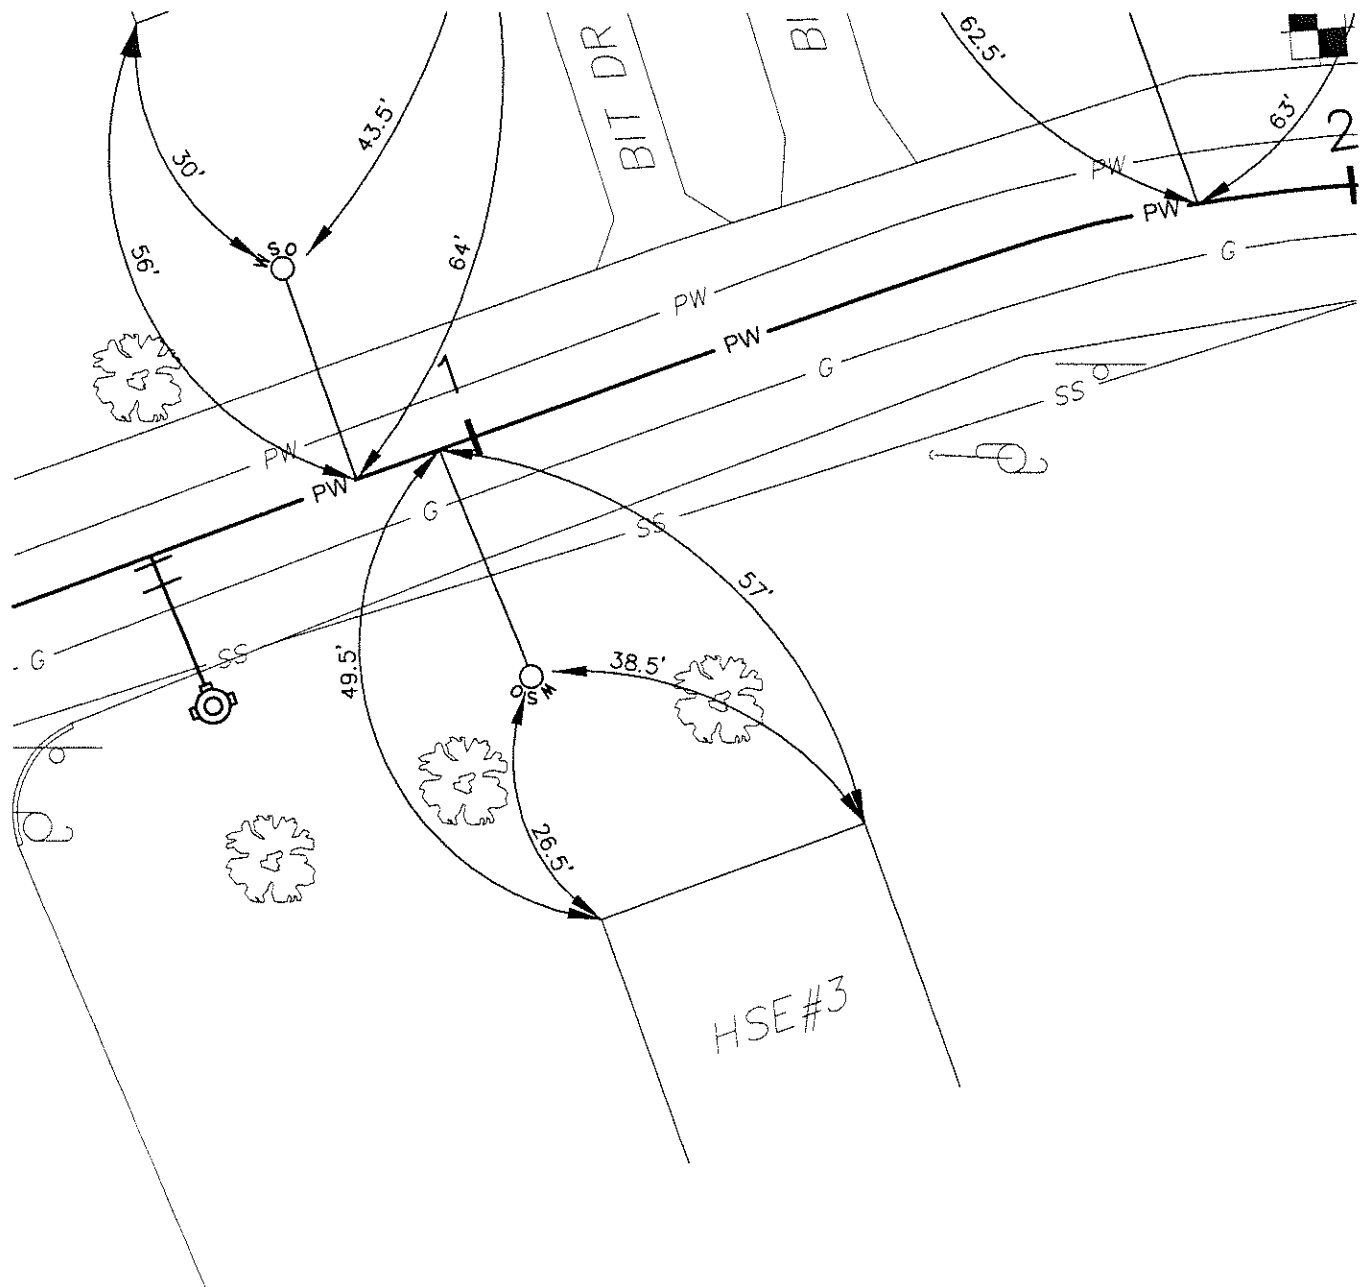

## HOUSE SERVICE INFORMATION:

DEPTH AT MAIN: 5'  
 DEPTH AT PROPERTY LINE: 4'  
 DATE INSTALLED: 10/06/04

PREPARED BY TIGHE & BOND