


GREENACRE LANE - #6

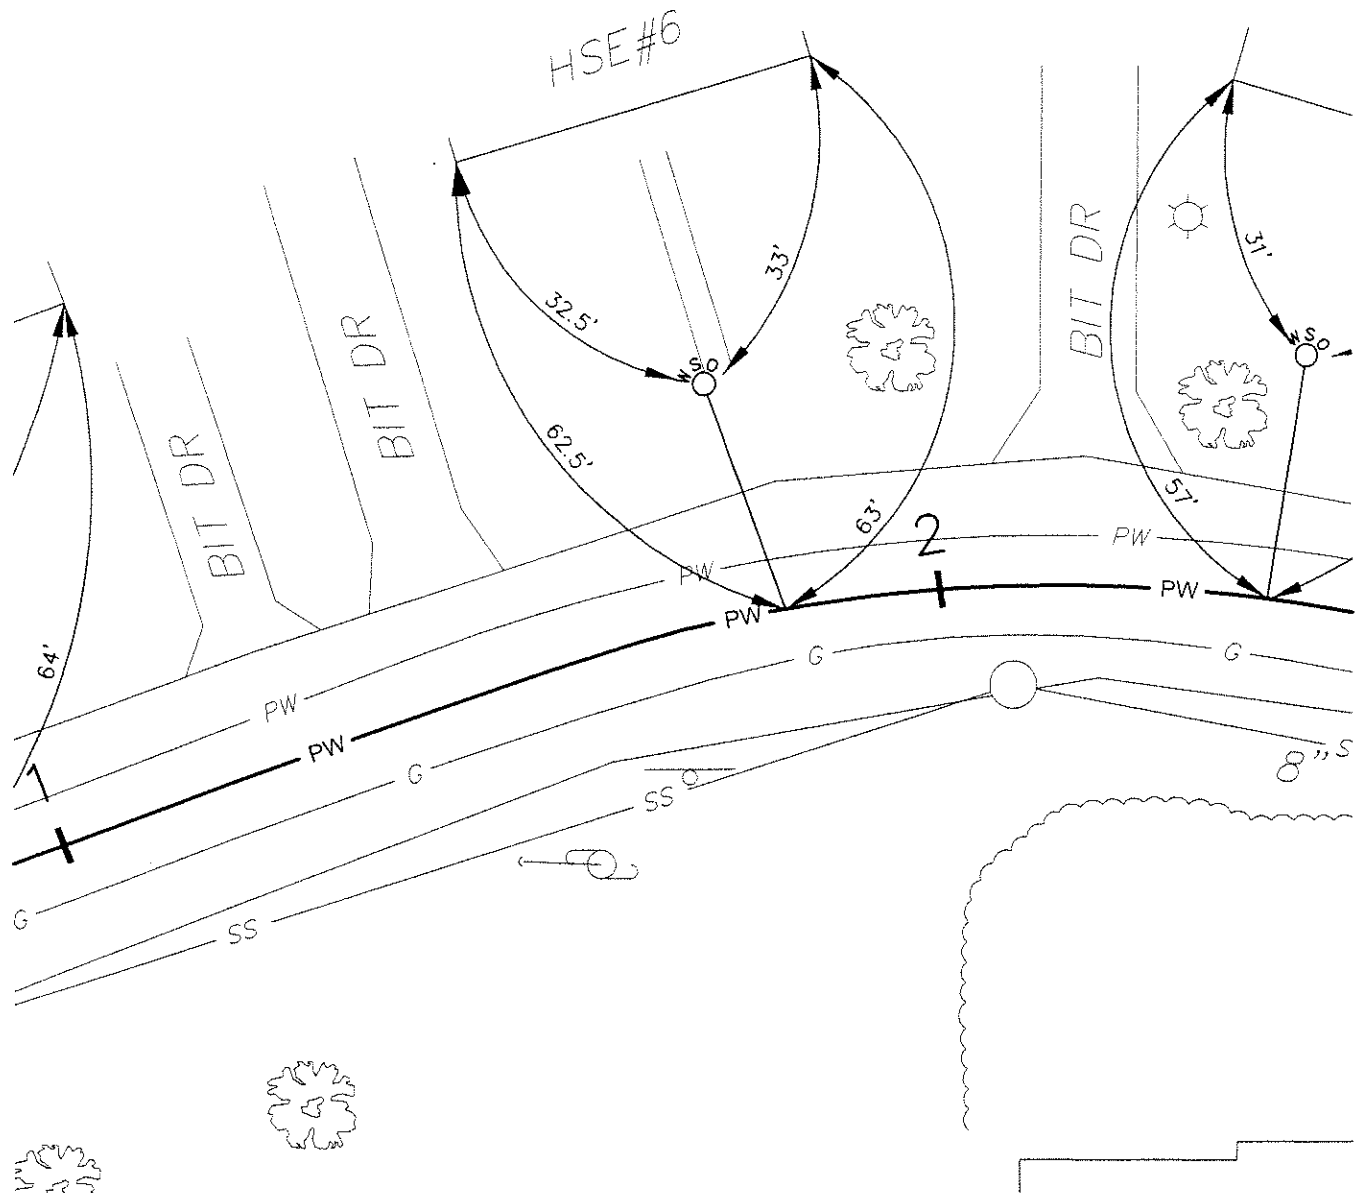

HOUSE SERVICE INFORMATION:

DEPTH AT MAIN: 5'
DEPTH AT PROPERTY LINE: 4'
DATE INSTALLED: 10/06/04

PREPARED BY TIGHE & BOND