


GREENACRE LANE - #9

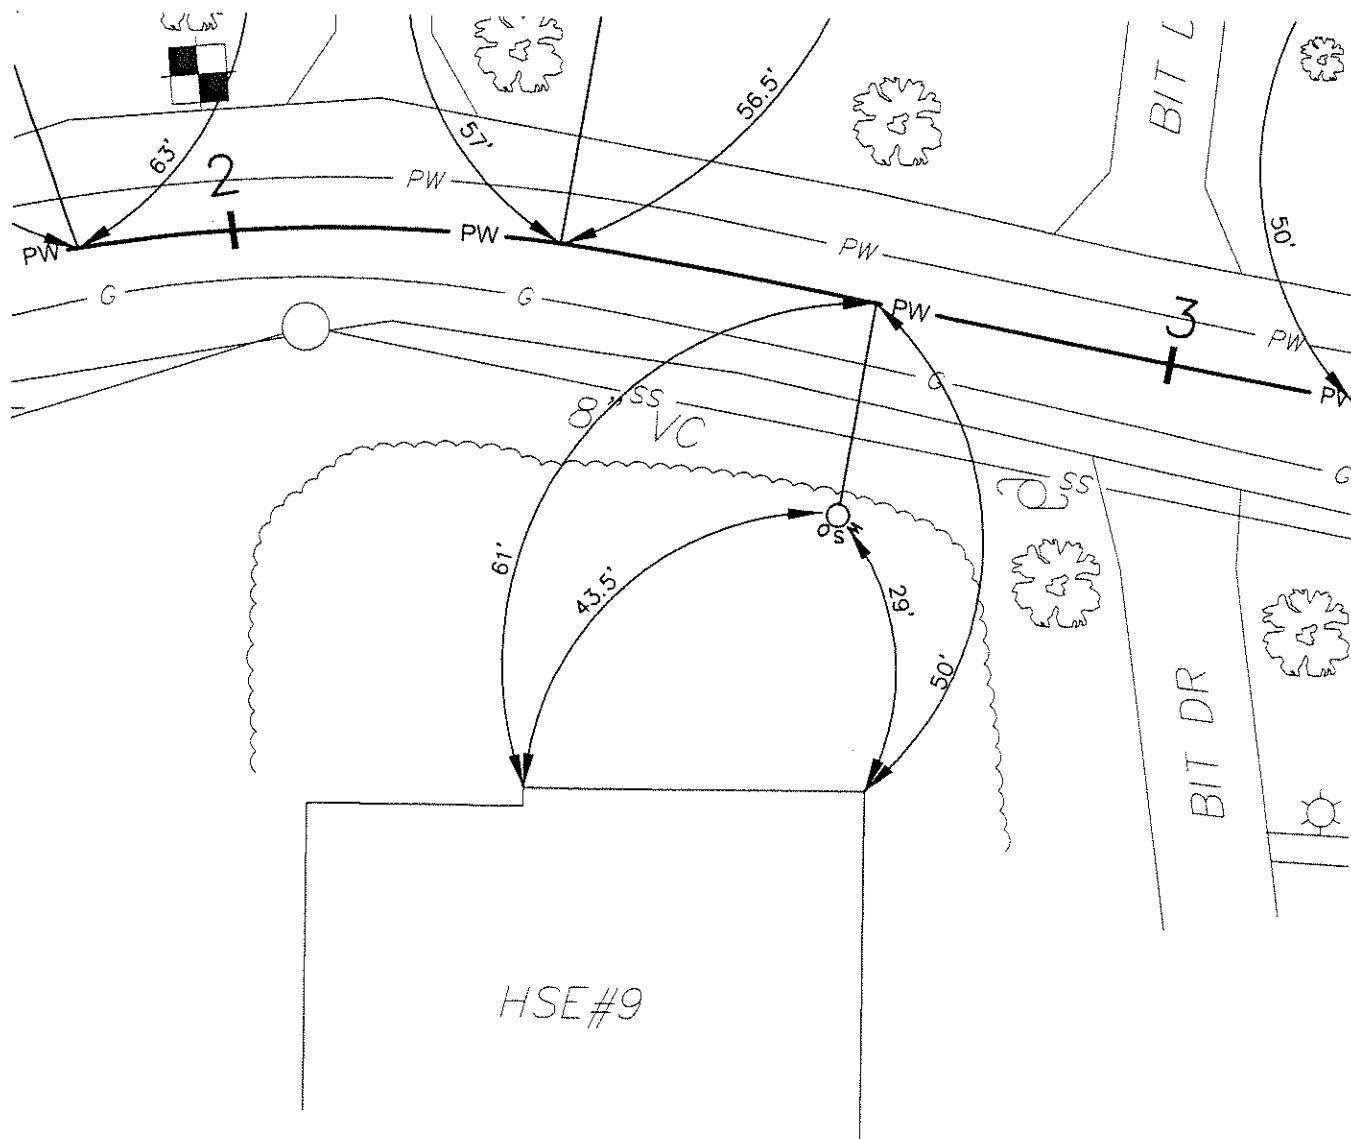

HOUSE SERVICE INFORMATION:

DEPTH AT MAIN: 5'
 DEPTH AT PROPERTY LINE: 4'
 DATE INSTALLED: 10/06/04

PREPARED BY TIGHE & BOND