


# GREENACRE LANE - #27

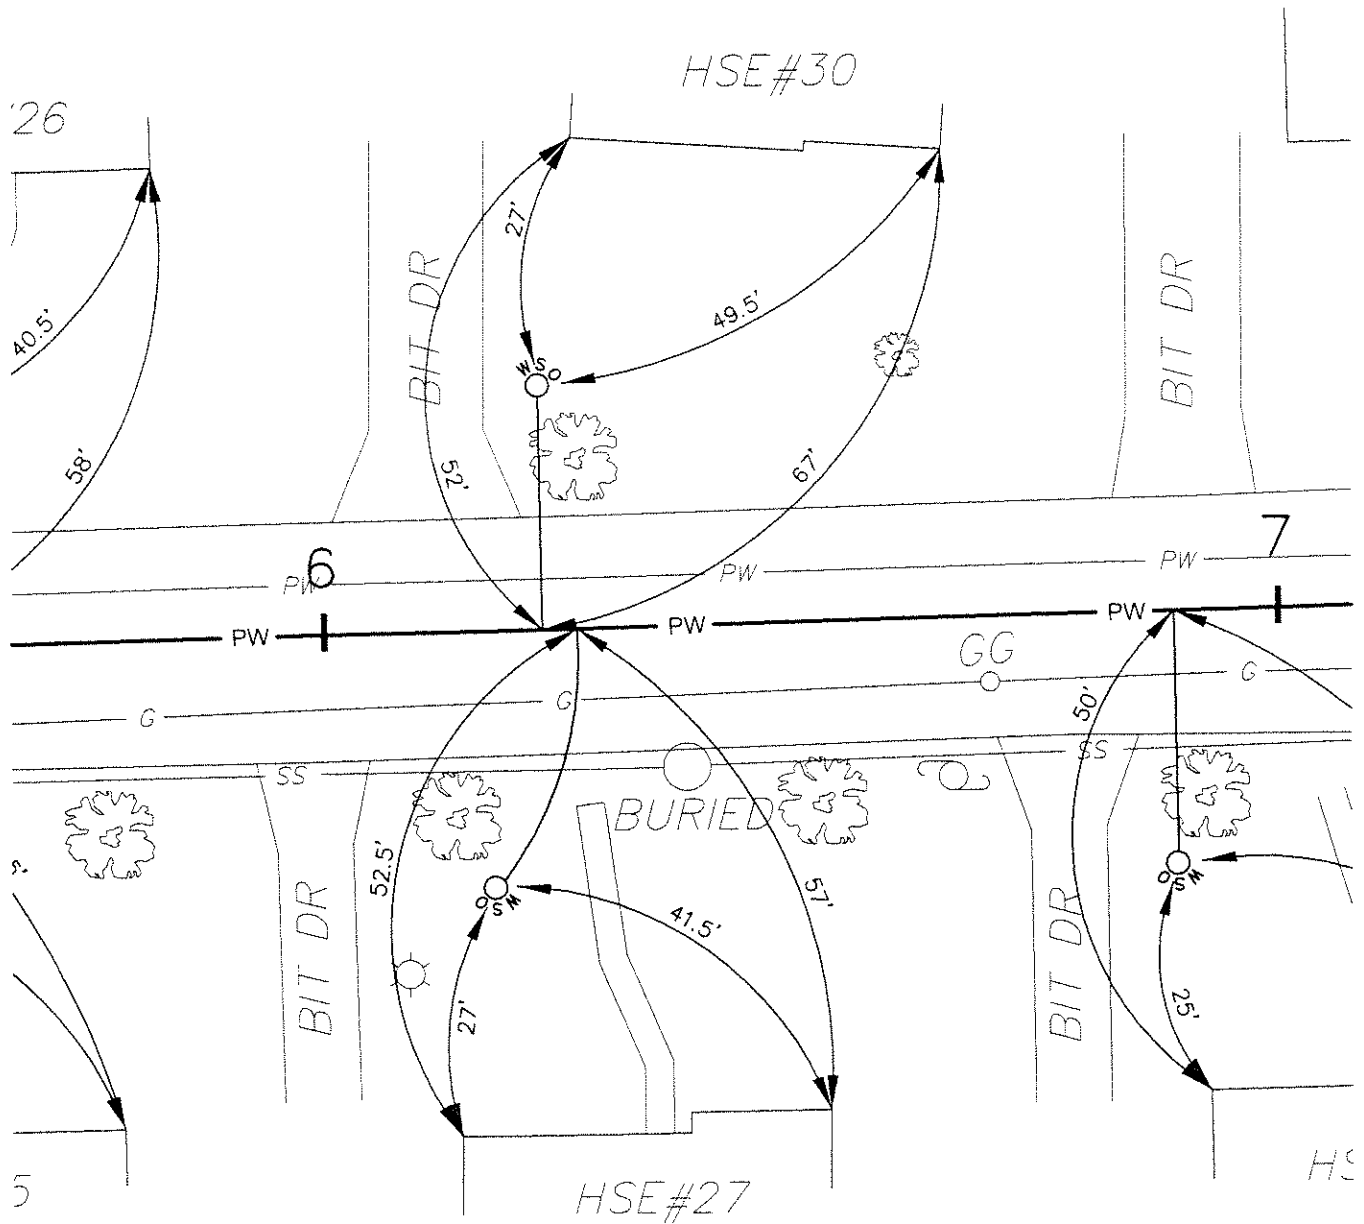

## HOUSE SERVICE INFORMATION:

DEPTH AT MAIN: 5'  
 DEPTH AT PROPERTY LINE: 4.5'  
 DATE INSTALLED: 10/12/04

PREPARED BY TIGHE & BOND