


GREENACRE LANE - #31

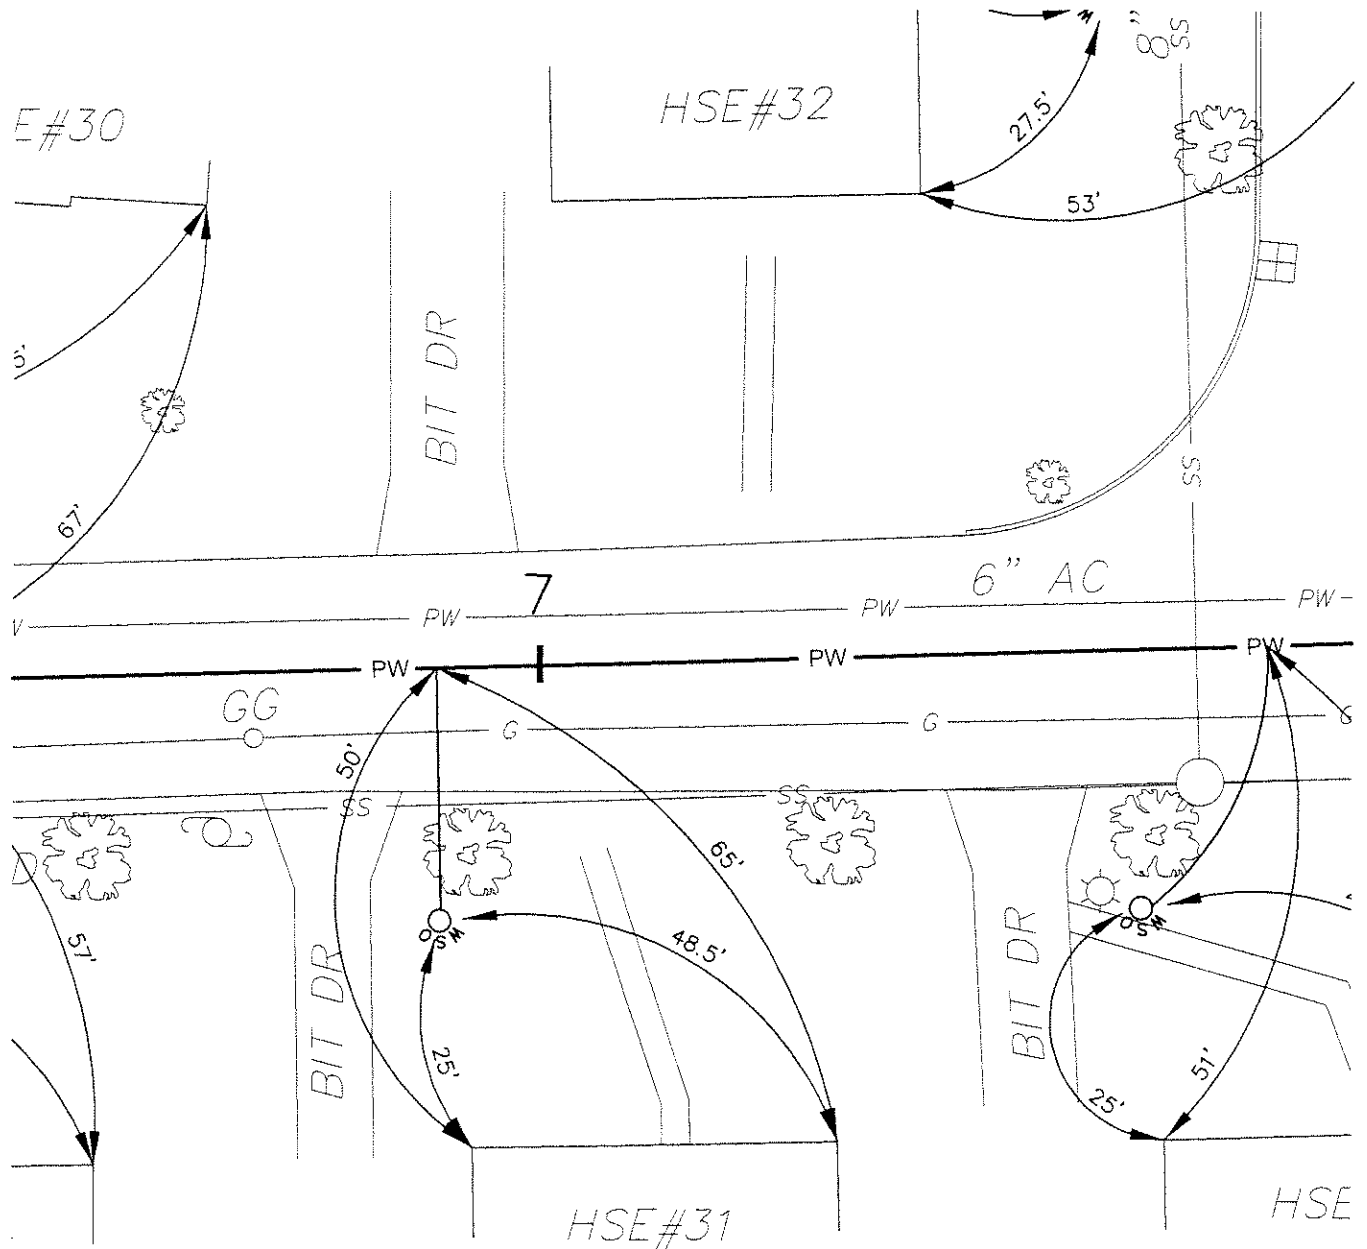

HOUSE SERVICE INFORMATION:

DEPTH AT MAIN: 5.5'
 DEPTH AT PROPERTY LINE: 4.5'
 DATE INSTALLED: 10/12/04

PREPARED BY TIGHE & BOND