


GREENACRE LANE - #35

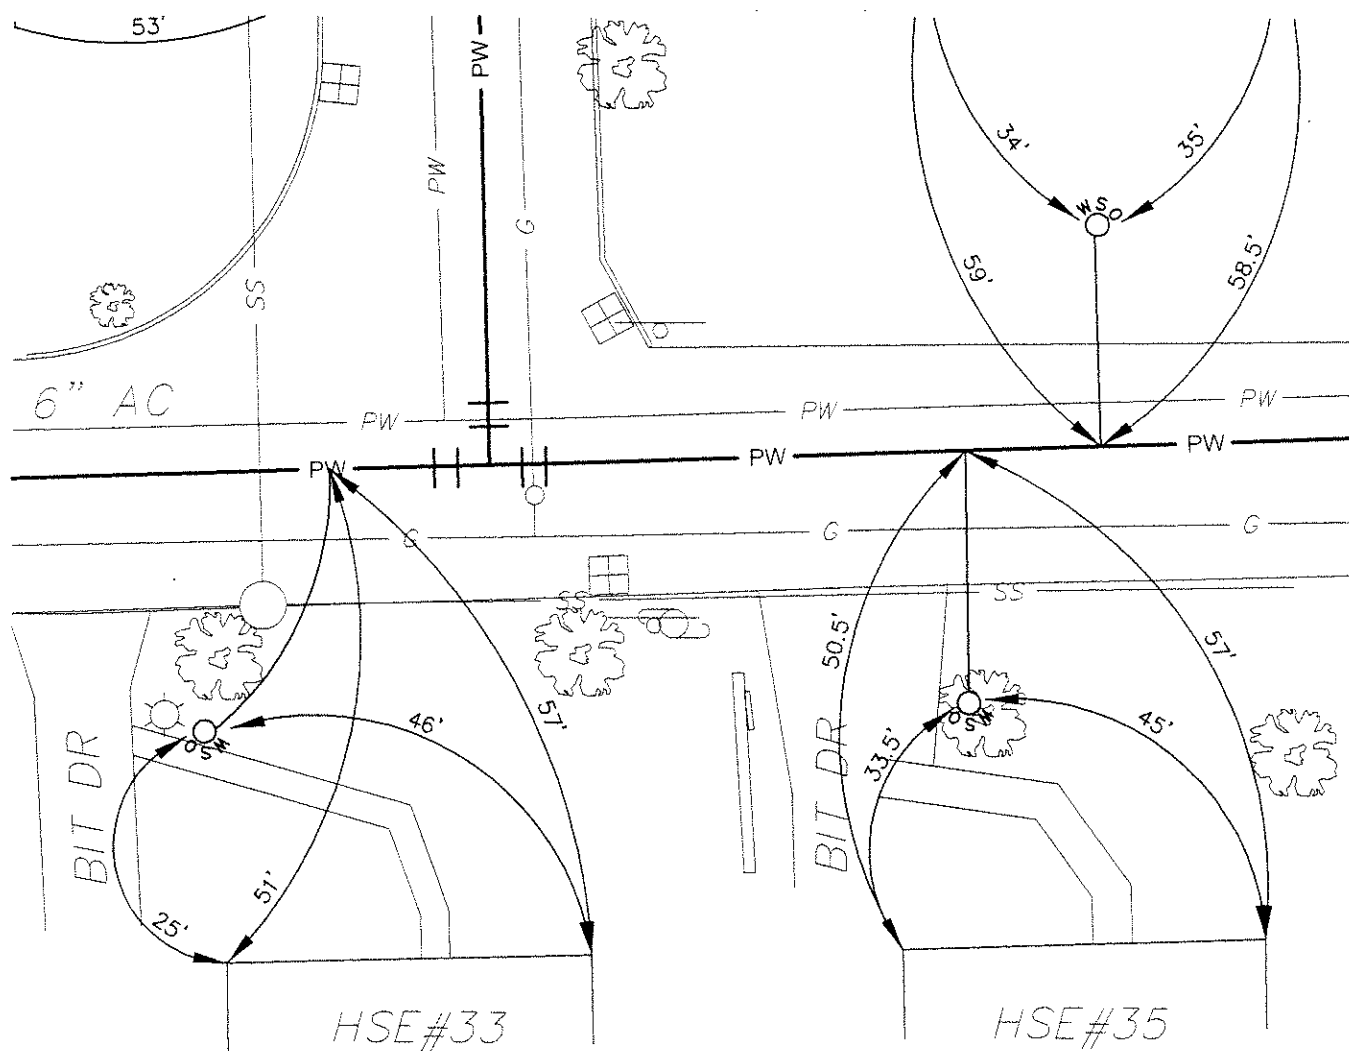

HOUSE SERVICE INFORMATION:

DEPTH AT MAIN: 6'
DEPTH AT PROPERTY LINE: 5'
DATE INSTALLED: 10/13/04

PREPARED BY TIGHE & BOND