


# GREENACRE LANE - #43

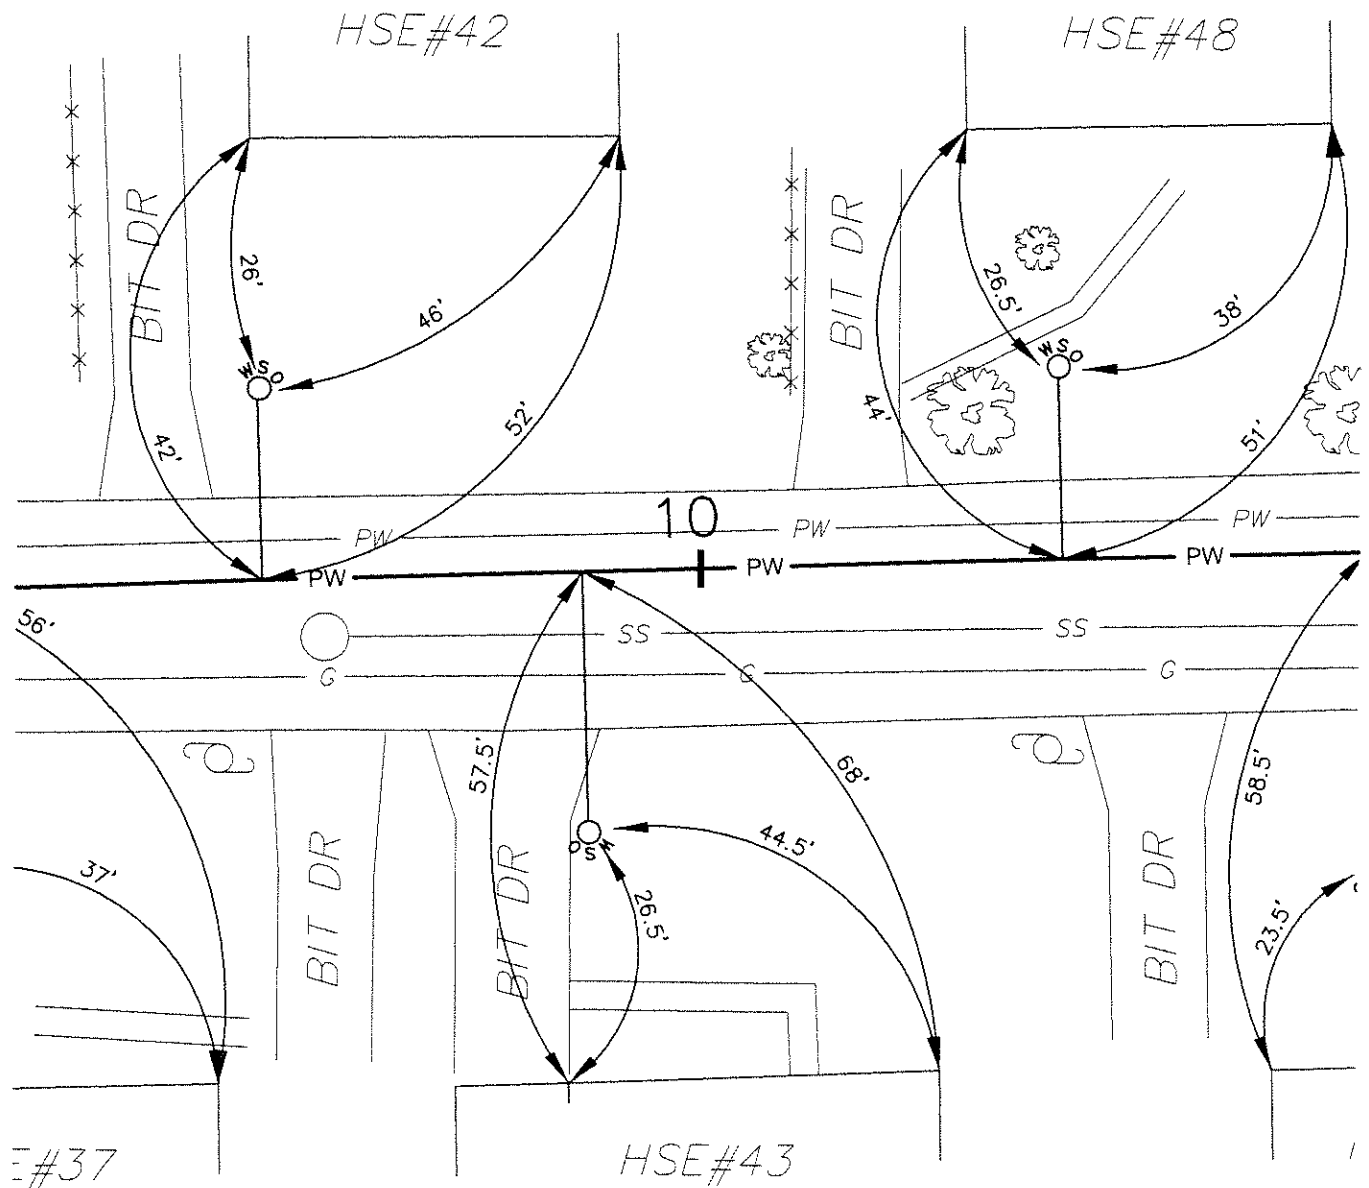

## HOUSE SERVICE INFORMATION:

DEPTH AT MAIN: 6'  
 DEPTH AT PROPERTY LINE: 5'  
 DATE INSTALLED: 10/13/04

PREPARED BY TIGHE & BOND