


GREENACRE LANE - #49

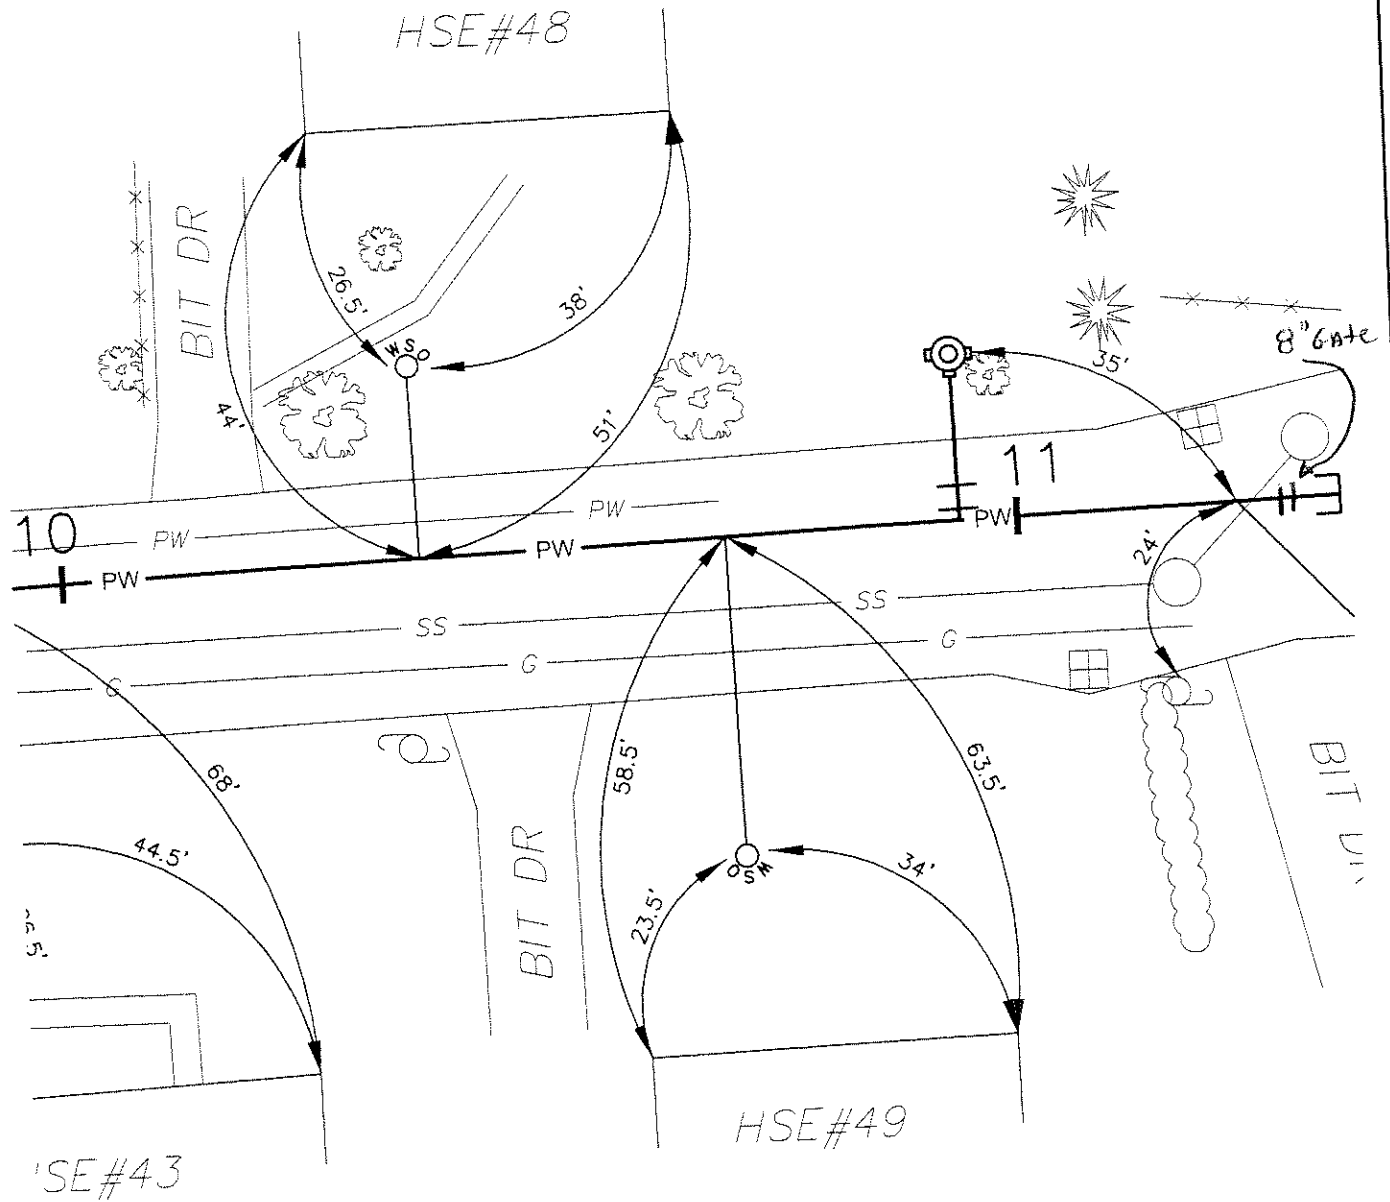

HOUSE SERVICE INFORMATION:

DEPTH AT MAIN: 6'
 DEPTH AT PROPERTY LINE: 5'
 DATE INSTALLED: 10/13/04

PREPARED BY TIGHE & BOND