


5/14/41

6/1

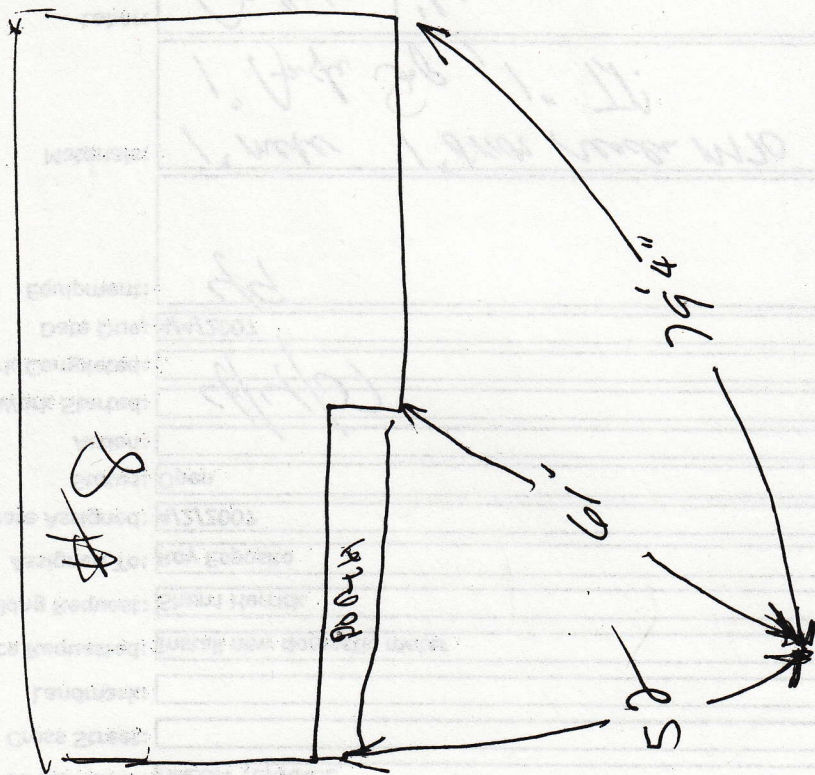

HALON TERRACE

EAST LONGMEADOW WORK ORDER: WATER