


## HAMLET STREET - #8

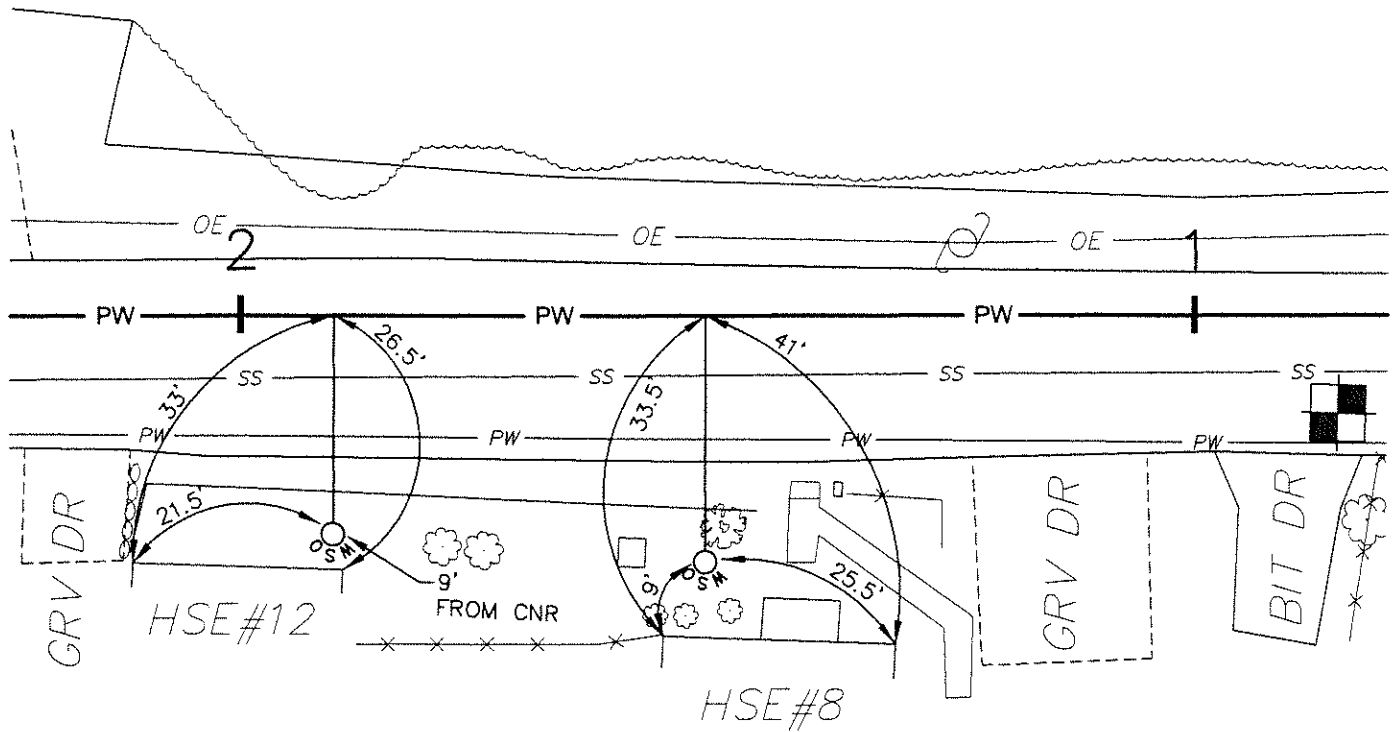

### HOUSE SERVICE INFORMATION:

DEPTH AT MAIN: 5'  
DEPTH AT PROPERTY LINE: 5'  
DATE INSTALLED: 11/19/04

PREPARED BY TIGHE & BOND