


HAMLET STREET - #12

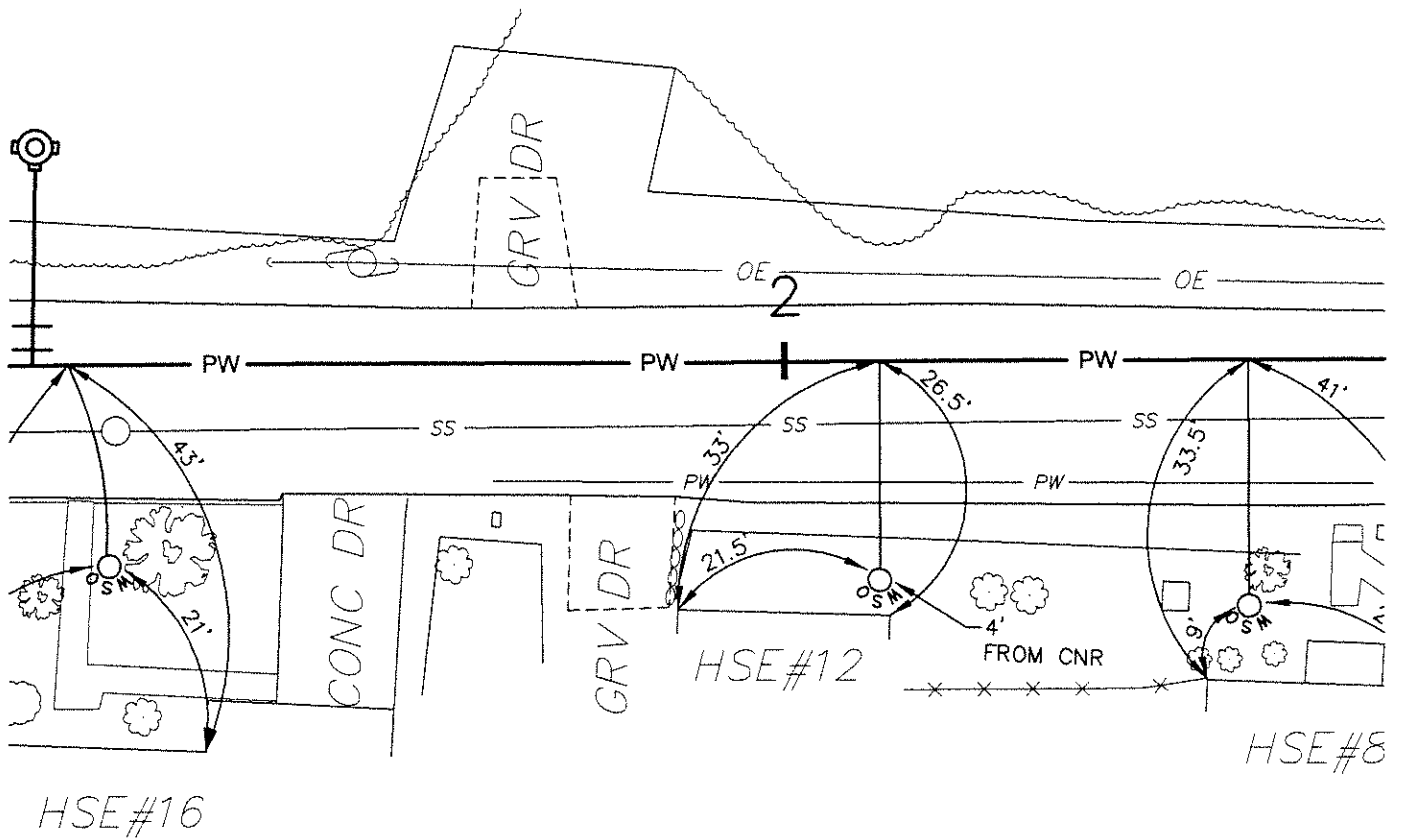

HOUSE SERVICE INFORMATION:

DEPTH AT MAIN: 5'
DEPTH AT PROPERTY LINE: 5'
DATE INSTALLED: 11/19/04

PREPARED BY TIGHE & BOND