

NO. STREET


DATE INST.

MAKE:

SIZE 1"

17 HOLLAND DRIVE

11/10

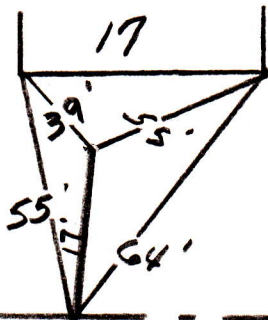

8" C900

1" CORP