

NO. STREET

DATE INST.


MAKE:

SIZE

1"

25 HOLLAND DRIVE

11/10

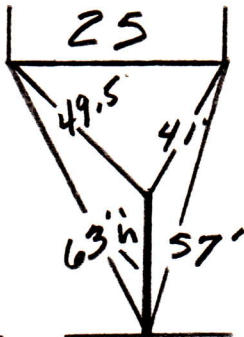

8" C900

1" CORP