

NO. STREET

DATE INST.


MAKE:

SIZE

1"

59 HOLLAND DRIVE

10/10

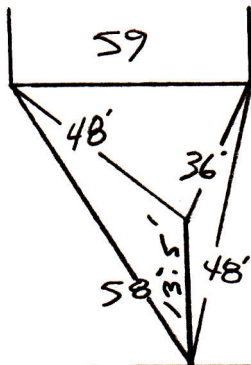

8" C900

1" CORP. 4' DEEP