

NO. STREET


DATE INST.

MAKE:

SIZE

62 HOLLAND DRIVE

11/10

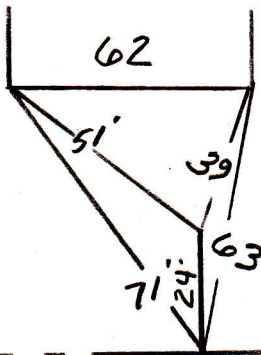

8" C900

1" CORP - 4.5' DEEP