

NO. STREET


DATE INST.

MAKE:

SIZE 1"

66 HOLLAND DRIVE

11/10

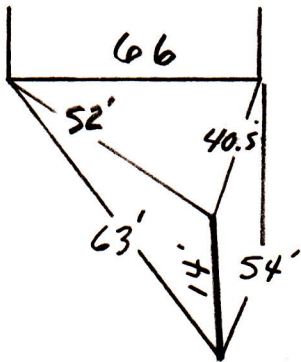

8" C700

1" CORP