


EAST LONGMEADOW DEPARTMENT OF PUBLIC WORKS

Job: 25 JOHN ST WATER SERVICE TIES

Sheet No: \_\_\_\_\_ of \_\_\_\_\_

Calculated By: T. LONGO Date 8.11.16

Scale: \_\_\_\_\_

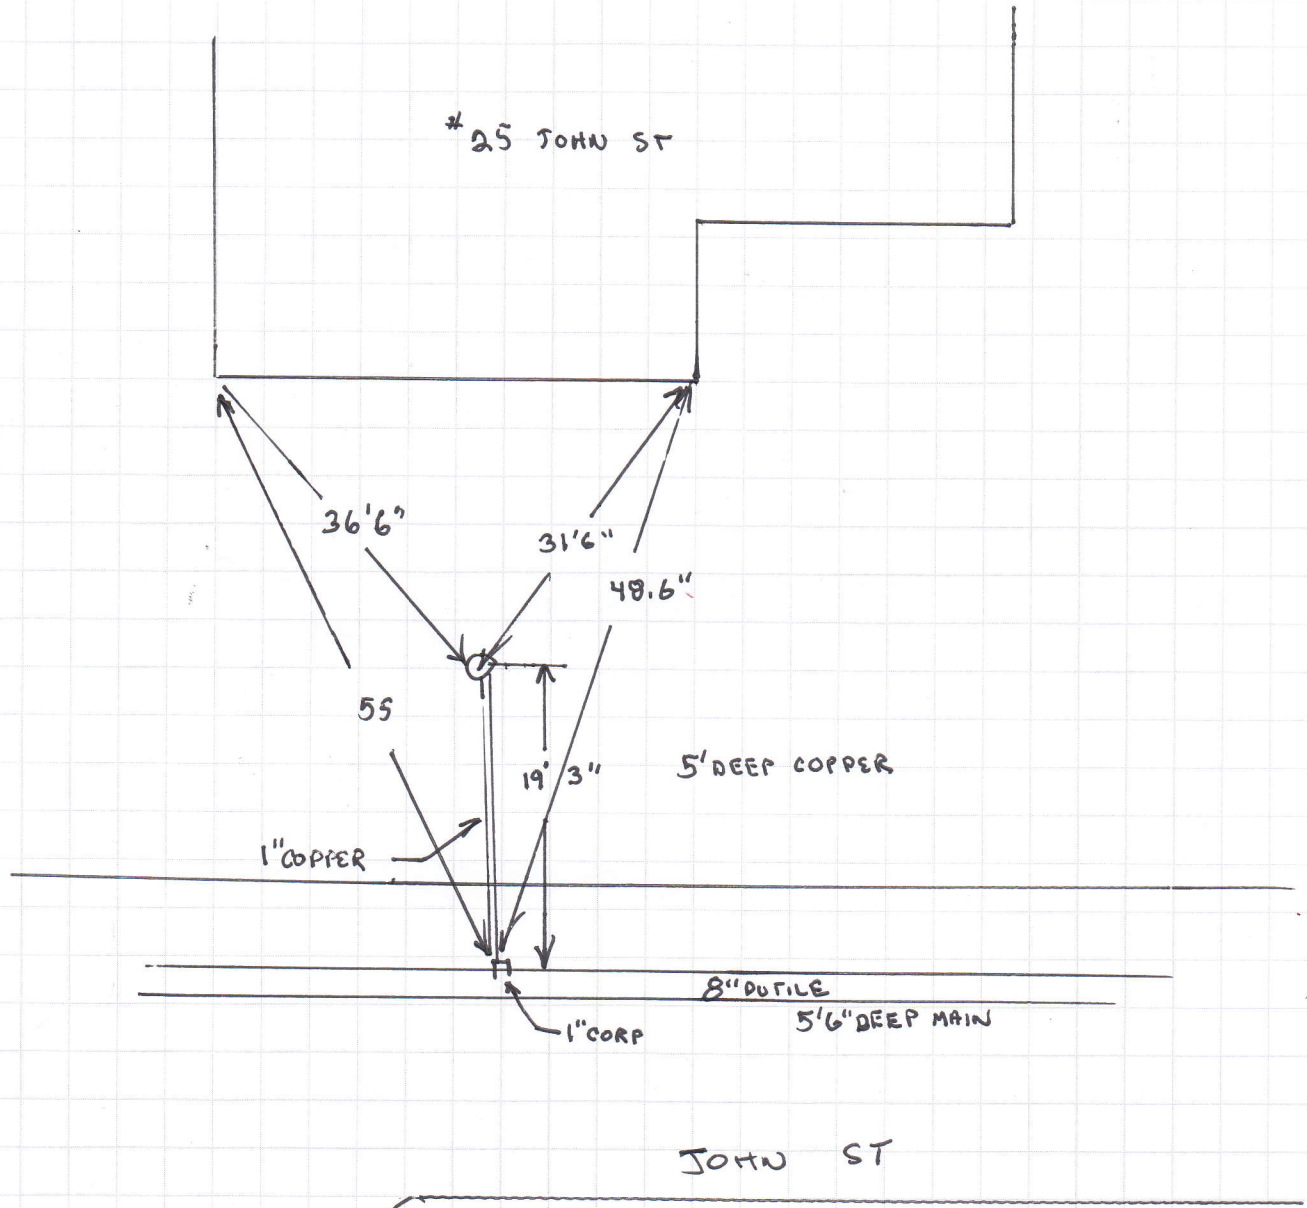

ALVIN