


EAST LONGMEADOW DEPARTMENT OF PUBLIC WORKS

Job: 42 JOHN ST
Sheet No: _____ of _____
Calculated By: T. LONGO Date 8.9.16
Scale: _____

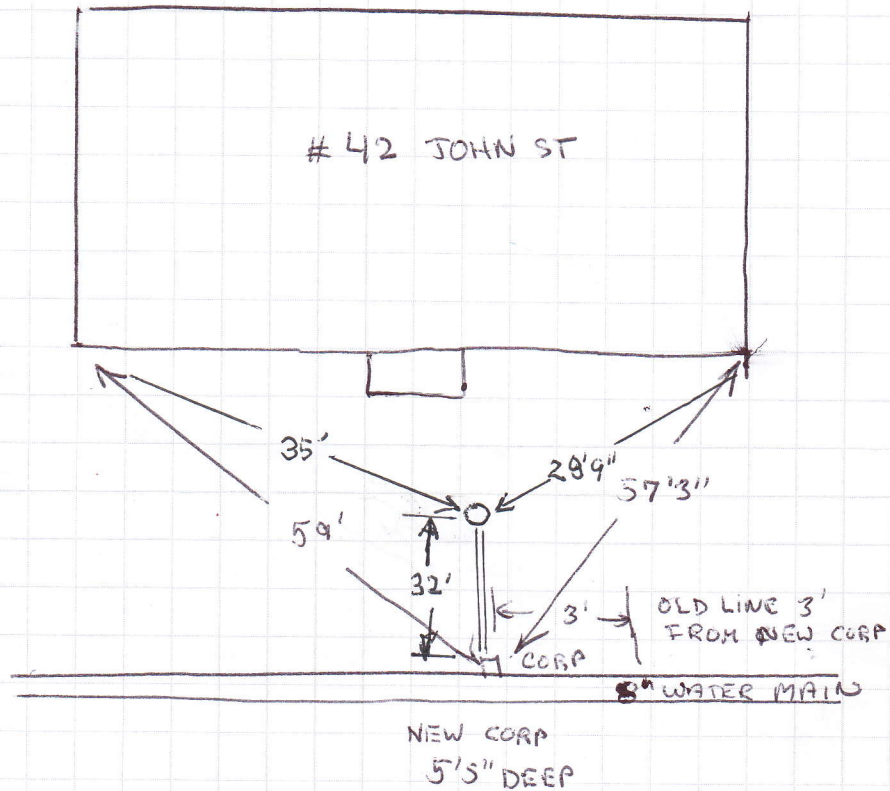

INSTALLED NEW 1" COPPER
SERVICE TO CORB BOX 8.9.16