


EAST LONGMEADOW DEPARTMENT OF PUBLIC WORKS

Job: 48 JOHN ST

Sheet No: _____ of _____

Calculated By: T. LONGO Date 6.21.16

Scale: _____

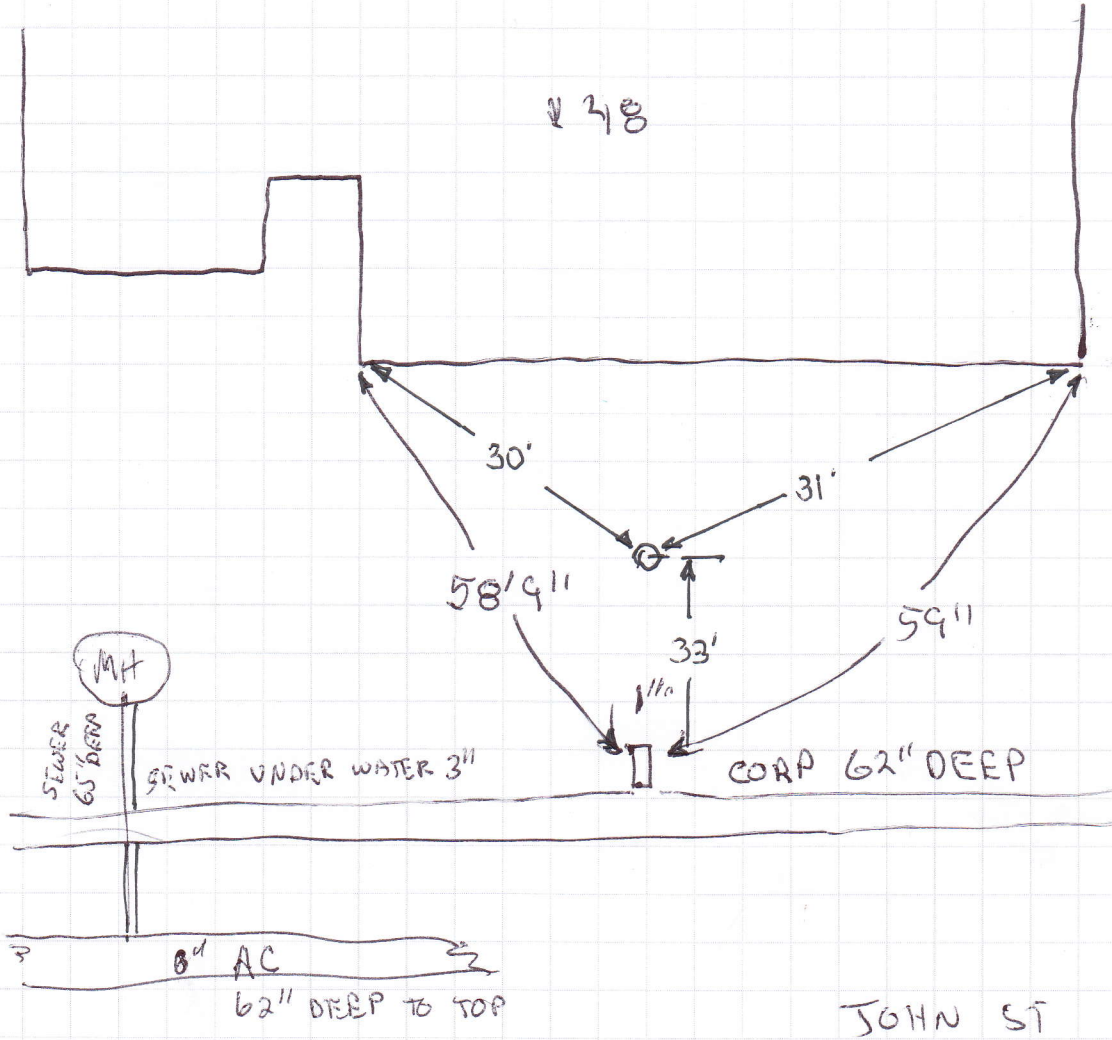

HELEN CIR