


KELSEY AVENUE - #6

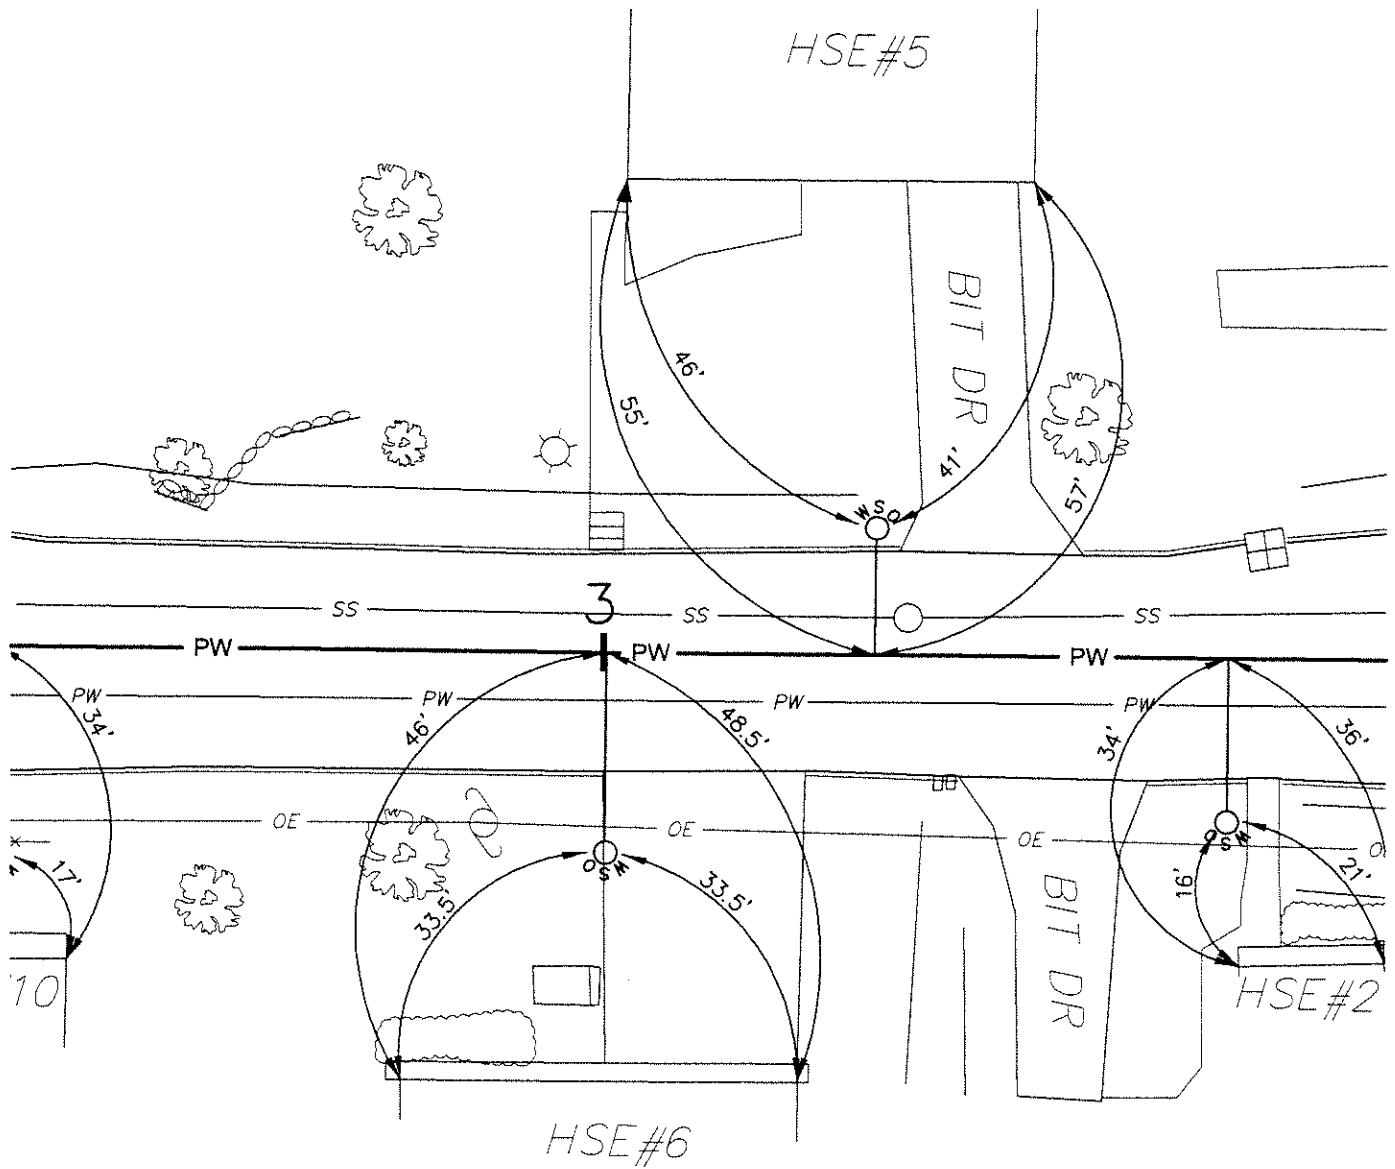

HOUSE SERVICE INFORMATION:

DEPTH AT MAIN: 5.5'
DEPTH AT PROPERTY LINE: 5'
DATE INSTALLED: 11/23/04

PREPARED BY TIGHE & BOND