


# KELSEY AVENUE - #19

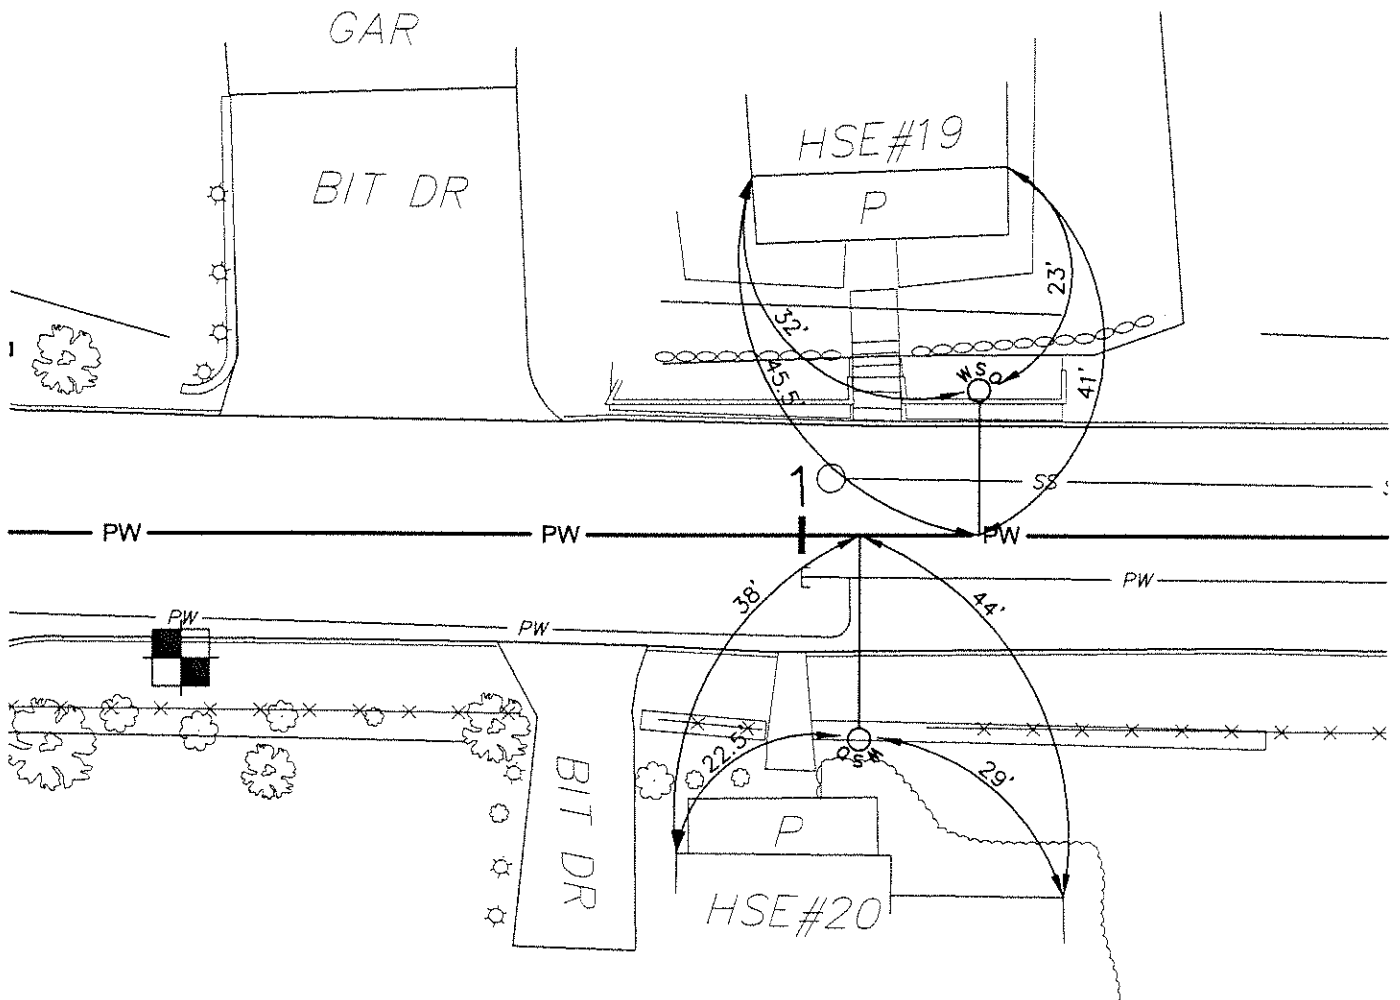

## HOUSE SERVICE INFORMATION:

DEPTH AT MAIN: 5'  
DEPTH AT PROPERTY LINE: 5'  
DATE INSTALLED: 11/23/04

PREPARED BY TIGHE & BOND