

NO. STREET


DATE INST.

MAKE:

SIZE

241 KIBBE ROAD

10-23-13

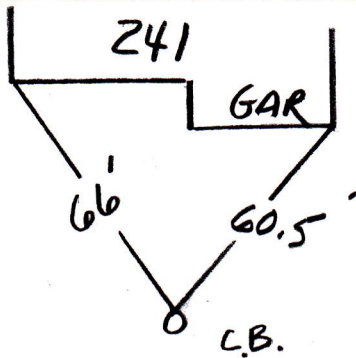

1" COPPER