


NO. STREET

DATE INST.

MAKE:

SIZE

66 LEE STREET

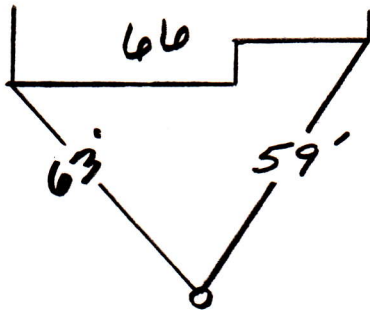

1" COPPER