


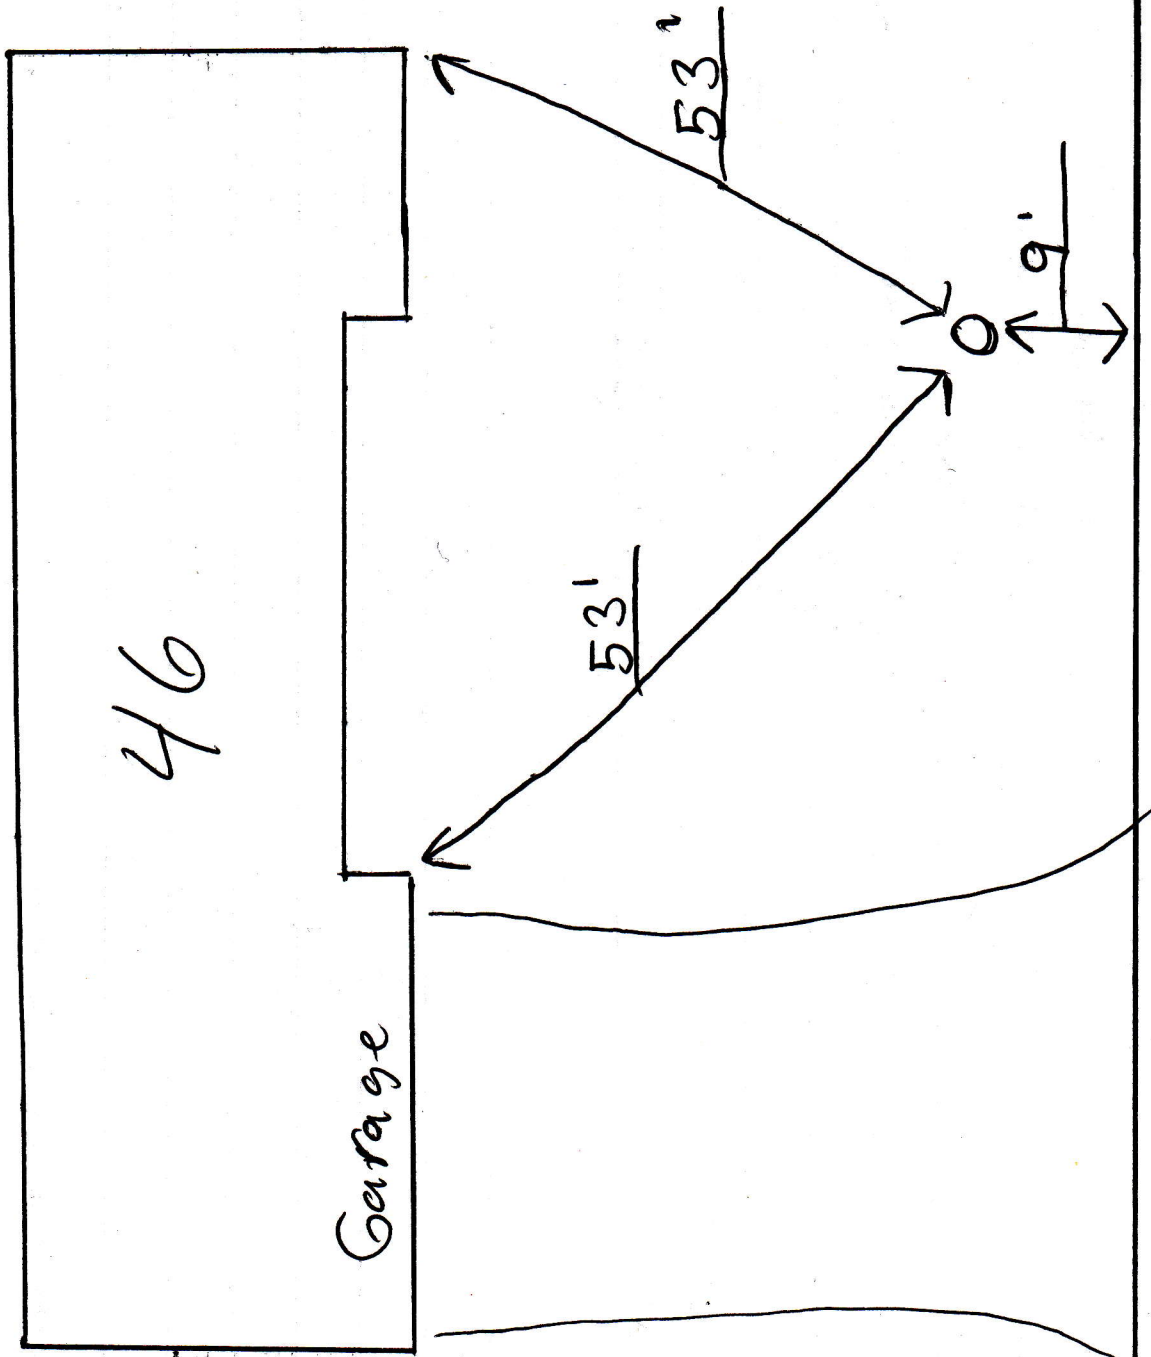

Lori Lane

10/3/14 Frank M.