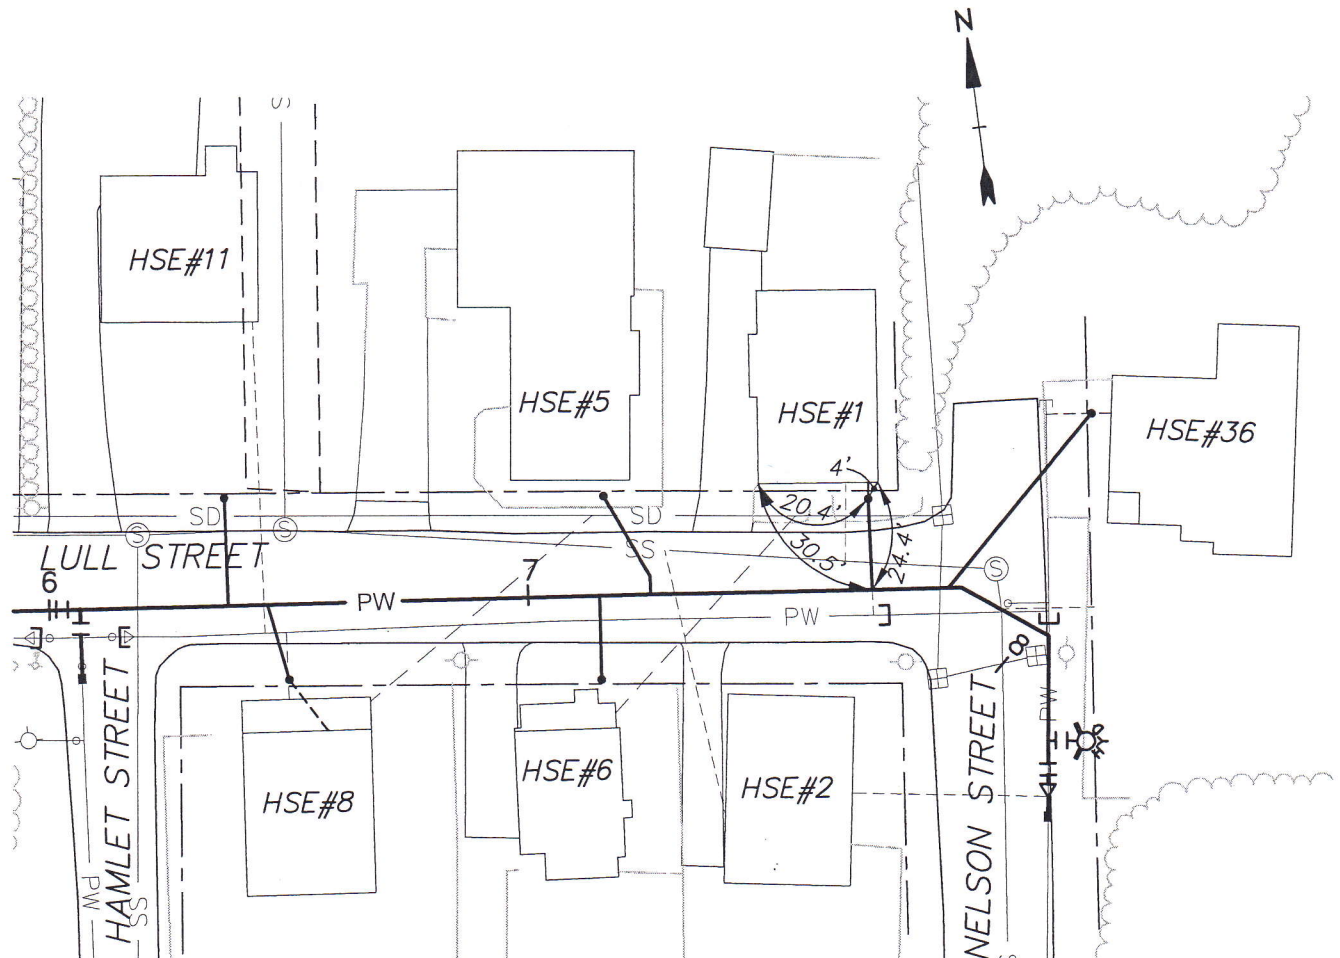


STREET ADDRESS: HSE#1 LULL STREET

LOAM & SEED	<u>6.0'x3.0'</u>
BIT. DRIVEWAY	_____
BIT. CURBS	_____
BIT. SIDEWALK	_____
CONC. CURB	_____
CONC. SIDEWALK	_____
TRENCH	<u>16'x3.2'</u>

SERVICE INSTALLED:	<u>8-22-07</u>
SIZE:	<u>1"</u>
MATERIAL:	<u>1-CORP., 1-C. STOP WITH BOX</u>
DEPTH AT MAIN:	<u>5.0'</u>
DEPTH AT CURB STOP:	_____
LENGTH OF Cu PIPE:	<u>21.5'+0.5'=22'</u>

*R & R DRY STONE WALL
 *COPPER UNDER DRAIN PIPE