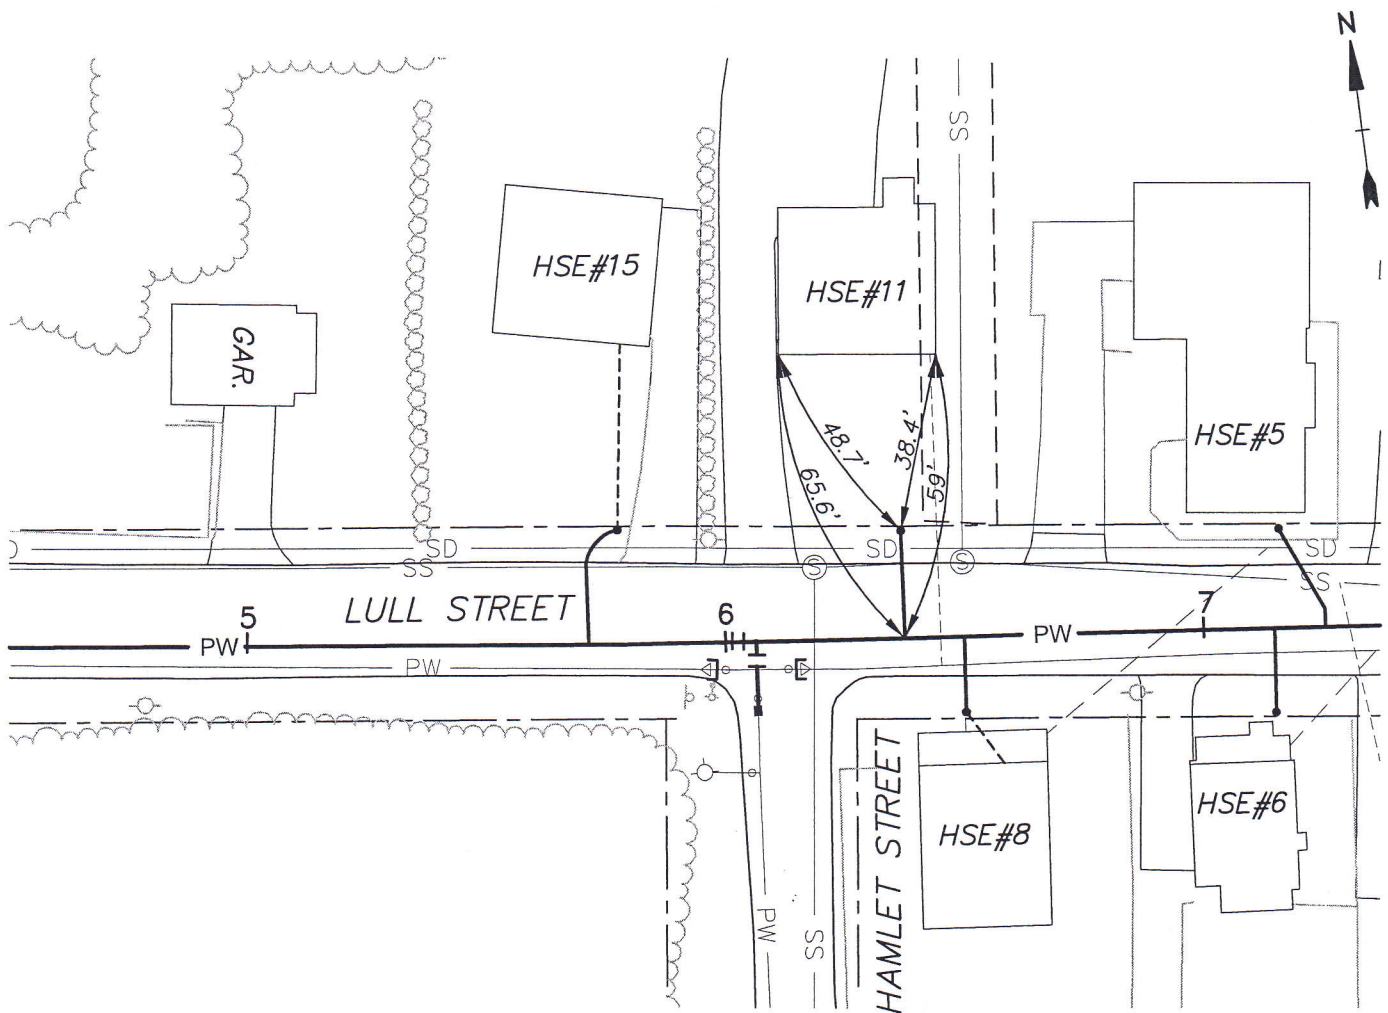


STREET ADDRESS: HSE#11 LULL STREET

|                |                             |
|----------------|-----------------------------|
| LOAM & SEED    | <u>7.5'x5.0'</u>            |
| BIT. DRIVEWAY  | <u>                    </u> |
| BIT. CURBS     | <u>4.2'</u>                 |
| BIT. SIDEWALK  | <u>                    </u> |
| CONC. CURB     | <u>                    </u> |
| CONC. SIDEWALK | <u>                    </u> |
| TRENCH         | <u>15.1'x3.7'</u>           |

|                     |                                    |
|---------------------|------------------------------------|
| SERVICE INSTALLED:  | <u>8-21-07</u>                     |
| SIZE:               | <u>1"</u>                          |
| MATERIAL:           | <u>1-CORP., 1-C. STOP WITH BOX</u> |
| DEPTH AT MAIN:      | <u>4.5'</u>                        |
| DEPTH AT CURB STOP: | <u>5.5'</u>                        |
| LENGTH OF Cu PIPE:  | <u>21.0'+1.0'=22'</u>              |

\*COPPER UNDER DRAIN PIPE  
 \*BROKE & REPAIRED 1" HDPE  
 SPRINKLER PIPE (UNMARKED)